

Lewis County Public Works
Chehalis, Washington 98532
May 12, 2021

ATTENTION: All Bidders and Planholders

2019 County Safety Program – Phase 2, F. A. Project No. HSIP-000S(553), CRP 2191B

Addendum No. 2

The Contract Documents for this project are amended as follows:

Special Provisions

- 1. The Attached Section 7-06 Temporary Stream Diversion shall be added to Division 7 of the Contract.**
- 2. The attached Section 8-02 with new bid item.**
- 3. The attached new Proposal for Appendix C**
- 4. The attached 9 pages of revised Contract Plans to be replaced in Appendix F**

Bidders shall furnish the County with evidence of receipt of this Addendum. This Addendum will be incorporated in the contract when awarded and when formally executed.



05/12/2021

Geoff Soderquist, P.E.
Assistant County Engineer

Attachment:

Section 7-06
Section 8-02
New Proposal pages
9 revised Contract Plan pages

1 (*****)

2 **7-06 Temporary Stream Diversion**

3 **7-06.1 Description**

4 This work shall include designing, installing, operating, maintaining, removing, and disposing of the
5 temporary stream diversion, environmental compliance and other Work as detailed in these
6 Specifications.

7
8 **7-06.2 Materials**

9 All materials shall be as detailed in the Contractor's Temporary Stream Diversion (TSD) Plan.

10
11 **7-06.3 Construction Requirements**

12 ***7-06.3(1) General***

13 The Work shall include compliance with Washington State Water Quality Standards in WAC
14 173-201A, project permits, environmental commitments and these Provisions.

15
16 The temporary stream diversion may be either a gravity or a pumped system. Pump screens
17 must comply with the requirements of these Special Provisions. Once a pumped diversion
18 begins, the pump must run continuously until it is no longer necessary to bypass flows. The
19 Contractor shall have back-up pumps on site and shall provide twenty-four hour monitoring of
20 the pumping operation. Monitoring can be achieved by providing monitoring personnel on site or
21 through remote sensing and instrumentation to verify operation of the bypass. If the Contractor
22 elects to monitor by remote sensing and instrumentation, a Type 2 Working Drawing shall be
23 submitted outlining how system operation will be monitored, how alerts will be made and how
24 personnel will respond to a diversion system failure.

25
26 The temporary stream diversion including water that is retained by the temporary stream
27 diversion and any dewatering system shall be located within the permitted impact areas as
28 shown in the Plans. The upstream diversion dam shall be constructed to a height sufficient to
29 prevent stream flow from entering the work area. Scour protection shall be provided at the
30 outfall of the temporary stream diversion systems and dewatering system to prevent flow re-
31 entering the stream channel from mobilizing streambed and embankment sediments. When a
32 temporary stream diversion is located in or near an intertidal zone the temporary stream
33 diversion design shall take tidal influence into consideration.

34
35 For each temporary stream diversion the Contractor shall arrange a meeting with the Engineer
36 prior to implementation of the TSD Plan. At this meeting the Contractor shall explain to the
37 Engineer the Work to be completed for the temporary stream diversion. The meeting shall be a
38 minimum of 7 calendar days prior to start of the temporary stream diversion work.

39
40 The TSD shall be operational prior to performing any other work below the Ordinary High Water
41 Line.

42
43 ***7-06.3(2) Temporary Stream Diversion Plan***

44 ***7-06.3(2)A General Plan Requirements***

45 The Contractor shall submit a Temporary Stream Diversion Plan in accordance with the
46 requirements of a Type 2E Working Drawing and these Specifications. A separate TSD
47 Plan shall be prepared and submitted for each temporary stream diversion that is required.
48 The TSD Plan shall consist of a narrative and drawings detailing all temporary stream
49 diversion requirements and shall encompass and protect all the areas affected by the
50 Contractor's temporary stream diversion Work.

1 The Contractor shall fully implement the TSD Plan throughout the duration of the associated
2 Work. The Contractor shall update the TSD Plan throughout project construction to reflect
3 actual site conditions and the Contractor's Work. Changes to plan shall comply with WAC
4 196-23-020. At the request of the Engineer an updated TSD Plan shall be submitted as a
5 Type 2E Working Drawing. A copy of the TSD Plan shall be on the project site at all times.
6

7 The TSD Plan shall describe measures that will be taken to comply with Washington State
8 Water Quality Standards in WAC 173-201A, applicable permits, environmental
9 commitments and these Provisions.

10
11 The Contractor shall incorporate the Diversion Schedule and Sequence into their Progress
12 Schedule.

13
14 (*****)

15 **7-06.3(2)B Stream Flows**

16 **Minimum Stream Flows**

17 At all times of operation the Contractor's temporary stream diversion shall be designed
18 to convey the following minimum flow rate of water in cubic feet per second:

19
20 *** \$\$\$ cfs for the summer high flow \$\$ ***
21

22 During all phases of the bypass installation and decommissioning, the Contractor shall
23 maintain flows downstream of the project site.
24

25 (*****)

26 **7-06.3(2)C Plan Requirements**

27 The TSD Plan shall provide the following information in the following order:

- 28
- 29 1. Description and Location of the temporary stream diversion
 - 30
 - 31 a. Identify the name of the water body where the temporary stream diversion will
32 be placed. Provide a description of the temporary stream diversion.
33
 - 34 b. Provide drawings showing the location of the temporary stream diversion,
35 including proposed access routes and equipment to be used to construct the
36 diversion.
37
 - 38 2. Schedule and Sequence
 - 39
 - 40 a. Provide a sequence of Work, dates, and durations for when the following will
41 occur, in accordance with the in-water work window in the Special Provisions:
42
 - 43 i. TSD Plan Implementation Meeting
 - 44
 - 45 ii. TSD installation.
 - 46
 - 47 iii. Dewatering of the isolated Work area.
 - 48
 - 49 iv. Restoration and stabilization of the temporary stream diversion Work
50 area to prevent erosion.
51

1
2
3
- vi. Any relocations of the temporary stream diversion to accommodate the Work sequence (if needed).
 - vii. Channel rewatering.
 - viii. Removal of the TSD.
 - b. Include other Work that needs to be coordinated with the TSD (e.g., temporary erosion control).
3. Calculations and Materials
- a. Detail all elements of the temporary stream diversion; including but not limited to pipes, pumps, and other equipment.
 - b. Calculations shall demonstrate the diversion system conveys the minimum peak flow specified by the Contracting Agency and include tidal influence where applicable.
 - c. Temporary stream diversion shall include a water conveyance system to be used for dewatering and rewatering that is capable of conveying the flow required for the temporary stream diversion.
 - d. Methods for anchoring temporary stream diversion pipe and associated hardware; include calculations to demonstrate the devices ability to anchor the pipe and associated hardware.
 - e. Specifications for all materials and equipment to be used as part of the diversion including pump or diversion capacities and hose sizes. For example, provide the type, profile, and size of pipe.
4. Stream Flow Blocking and Dewatering
- a. Provide the method(s), including locations and details (narrative and drawings) for blocking both the upstream and downstream ends of the diversion. Describe how minor leakage from upstream and downstream will be addressed.
 - b. Include provisions for scour protection at the temporary stream diversion outfalls.
 - c. Identify the means and methods for dewatering water and disposal of the water.
5. Inspection and Maintenance
- a. Provide the schedule and frequency for inspection of the temporary stream diversion; include weekends and holidays.
 - b. Describe how maintenance will be conducted when inspections identify deficiencies in the temporary stream diversion. These include, but are not

1 limited to removal and disposal of trapped sediment or debris and repairing
2 leaks.

3
4 c. The Contractor shall keep a record of all inspections and maintenance of the
5 temporary stream diversion.
6

7 6. Rewatering the Stream Channel
8

9 a. Detail how the stream channel will be rewatered to comply with water quality
10 requirements.
11

12 7. Removal of the Temporary Stream Diversion
13

14 a. Describe the sequence that will be used for removing the temporary stream
15 diversion and methods to prevent water quality impacts.
16

17 b. Describe how disturbed soil will be permanently stabilized.
18

19 c. Describe any temporary pipes to remain (requires approval of the Engineer):
20 their type, pipe class, size, location, and plugging procedure.
21

22 8. Other Work required for the Contractor's temporary stream diversion
23

24 **7-06.3(5) Inspection and Maintenance**

25 At a minimum, the Contractor shall perform the following activities once per day (including
26 weekends and holidays):
27

- 28 1. Check for and correct leaks;
29

30 The Contractor shall maintain a written record of all inspection and maintenance activities;
31 record to be available at the request of the Engineer.
32

33 **7-06.3(6) Rewatering the Stream Channel**

34 The Contractor shall notify the Engineer a minimum of 7 calendar days in advance of rewatering
35 the stream channel.
36

37 The Contractor shall introduce water to the new stream channel section and trap sediments until
38 the stream section meets the requirements of these Provisions. Rewatering shall occur at a rate
39 to avoid loss of surface water downstream while the new channel section is rewatered.
40

41 **7-06.3(7) Removal of the Temporary Stream Diversion**

42 The Contractor shall notify the Engineer two business days in advance of beginning the
43 temporary stream diversion removal sequence.
44

45 Once the water in the new stream channel will meet the applicable turbidity standards the
46 Contractor may begin removal of the temporary stream diversion and the stream channel
47 opened to flows.
48

49 The Contractor shall immediately take all corrective actions necessary to prevent the water from
50 exceeding the turbidity standards should the stream turbidity increase. All Work within the
51 channel, except for removal of the temporary erosion control items, shall be completed before

1 the temporary stream diversion is removed. The Contractor must finish all construction activities
2 within the limits of the Ordinary High Water Line, including but not limited to culvert installation
3 and creek bed channel restoration, before the Contracting Agency will remove the fish block
4 nets.

5
6 All materials used for the diversion shall become the property of the Contractor and removed
7 from the project limits, with the exception of any materials supplied by the Contracting Agency,
8 unless otherwise specified by the Engineer.

9
10 **7-06.4 Vacant**

11
12 **7-06.5 Payment**

13 Payment will be made for the following Bid items when included in the proposal:

14
15 (*****)

16 "Temporary Stream Diversion", lump sum.

17 The lump sum Contract price for "Temporary Stream Diversion" shall be full payment to perform
18 the Work as specified. Progress payments for the lump sum item "Temporary Stream Diversion"
19 will be made as follows:

- 20
21 1. Twenty-five percent of the bid amount will be paid following completion of the TSD Plan
22 including resolution of all Contracting Agency review comments.
23
24 2. The remaining seventy-five percent of the bid amount shall be paid in accordance with
25 Section 1-09.9.
26

27 **8-02 ROADSIDE RESTORATION**

28 **8-02.3 Construction Requirements**

29 Section 8-02.3 is supplemented with the following:

30
31 **8-02.3(9) Seeding, Fertilizing, and Mulching**

32
33 **8-02.3(9)B Seeding and Fertilizing**

34 (*****)

35 Section 8-02.3(9)B is supplemented with the following:

36
37 Seed Mix - Roadside: Grass seed, of the following composition, proportion, and quality shall be
38 applied at the rate of ***80 *** pounds of pure live seed per acre on all areas requiring
39 permanent roadside seeding within the project limits.

40
41 Kind and Variety of

42 Seed in Mixture by

43 Common Name and

44 (Botanical name)

Pounds Pure Live Seed

(PLS) Per Acre

45
46 *Deschampsia elongata*

5.88

47 Slender Hairgrass

48
49 *Elymus glaucus*

39

50 Blue Wildrye

1		
2	<i>Festuca idahonesis</i>	12.74
3	Idaho Fescue	
4		
5	<i>Festuca ovina</i>	4.21
6	Sheep Fescue	
7		
8	<i>Hordeum brachyantherum</i>	16.86
9	Meadow Barley	
10		
11	<i>Koeler cristata</i>	1.31
12	Prairie Junegrass	
13		
14	Total Pounds PLS Per Acre	80
15		

16 After seeding the Contractor shall be responsible to ensure a healthy stand of grass, otherwise,
 17 the Contractor shall, restore eroded areas, clean up materials, and reapply the seed, at no cost
 18 to the Contracting Agency.

19
 20 Seeds shall be certified "Weed Free," indicating there are no noxious or nuisance weeds in the
 21 seed.

22
 23 **8-02.3(11) Mulching**
 24 (*****)

25
 26 **8-02.3(11)A Mulch for Seeding Areas**

27
 28 Section 8-02.3(11)A is supplemented with the following:

29
 30 Long-Term Wood Cellulose Fiber mulch shall be applied at a rate of 4,000 pounds per acre with
 31 all permanent seed mixes and shall conform to Section 9-14.5(2)A Long-Term Mulch of the
 32 Standard Specifications. No more than 2,000 pounds shall be applied in any single lift.

33
 34 **8-02.4 Measurement**

35 Section 8-02.4 is supplemented with the following:

36
 37 (*****)
 38 "Seeding and Mulching" shall be measured per acre.

39
 40 **8-02.5 Payment**

41 Section 8-02.5 is supplemented with the following:

42
 43 (*****)
 44 The unit contract price per Acre for "Seeding and Mulching" shall be full pay for furnishing and
 45 installing the specified seed mix, mulch, and PAM, chemical weed and grass control/removal
 46 immediately prior to seeding to produce the specified surface conditions, scarification of
 47 compacted areas, minor filling of ruts, and all material and equipment necessary and incidental
 48 to the approved application of the specified seed.

49

PROPOSAL

TO: BOARD OF COUNTY COMMISSIONERS
LEWIS COUNTY
CHEHALIS, WASHINGTON 98532

This certifies that the undersigned has examined the location of the 2019 County Safety Program - Phase 2, F.A. Project No. HSP-000S(553), CRP 2191B, in Lewis County, Washington, and that the plans, specifications and contract governing the work embraced in these improvements, and the method by which payment will be made for said work is understood. The undersigned hereby proposes to undertake and complete the work embraced in this improvement, or as much thereof as can be completed with the money available in accordance with the said plans, specifications and contract, and the following schedules of rates and prices:

NOTE: Unit prices for all items, all extensions, and total amount of bid shall be shown: All entries must be typed or entered in ink.

ITEM NO.	PLAN QUANTITY	ITEM DESCRIPTION	UNIT PRICE DOLLARS CENTS	AMOUNT DOLLARS CENTS
1	1 L.S.	Mobilization	LUMP SUM	\$
2	1 L.S.	Clearing and Grubbing	LUMP SUM	\$
3	1 L.S.	Removal of Structures and Obstructions	LUMP SUM	\$
4	3 C.Y.	Hazardous Material Excavation Incl. Haul	\$	\$
5	0 Est.	Hazardous Material Handling and Disposal	ESTIMATED	\$0.00
6	10 C.Y.	Roadway Excavation	\$	\$
7	600 C.Y.	Roadway Excavation Incl. Haul	\$	\$
8	388 Ton	Select Borrow Incl. Haul	\$	\$
9	158 L.F.	Schedule A Culv. Pipe 18 In. Diam.	\$	\$
10	34 L.F.	Cl. III Reinf. Conc.Culv. Pipe 18 In. Diam.	\$	\$
11	72 L.F.	Cl. V Reinf. Conc.Culv. Pipe 24 In. Diam.	\$	\$
12	8 L.F.	Plain St. Culv. Pipe Arch, 0.109 In. Th., 64 In. Span	\$	\$
13	1 L.S.	Temporary Stream Diversion	LUMP SUM	\$
14	1 Each	Catch Basin Type 2, 48 In. Diam.	\$	\$
15	10 L.F.	Schedule A Storm Sewer Pipe, 24 In. Diam.	\$	\$
16	35 C.Y.	Gravel Backfill for Wall	\$	\$
17	2,800 Ton	Crushed Surfacing Base Course	\$	\$
18	110 Ton	Crushed Surfacing Top Course (Keystone)	\$	\$
19	6 Ton	Commercial HMA	\$	\$
20	2,240 L.F.	Wattle	\$	\$
21	156.25 L.F.	Beam Guardrail Type 1 - 8 Ft. Long Post	\$	\$
22	506.25 L.F.	Beam Guardrail Type 1 - 9 Ft. Long Post	\$	\$
23	62.5 L.F.	Beam Guardrail Type 1 - 11 Ft. Long Post	\$	\$

ITEM NO.	PLAN QUANTITY		ITEM DESCRIPTION	UNIT PRICE		AMOUNT	
				DOLLARS	CENTS	DOLLARS	CENTS
24	862.5	L.F.	Beam Guardrail Type 31 - 8 Ft. Long Post	\$		\$	
25	918.75	L.F.	Beam Guardrail Type 31 - 9 Ft. Long Post	\$		\$	
26	606.25	L.F.	Beam Guardrail Type 31 - 11 Ft. Long Post	\$		\$	
27	100	Each	Beam Guardrail Block	\$		\$	
28	2	Each	Beam Guardrail Non-Flared Terminal	\$		\$	
29	11	Each	Beam Guardrail Type 31 Non-Flared Terminal	\$		\$	
30	43.75	L.F.	Beam Guardrail Type 1	\$		\$	
31	150	L.F.	Beam Guardrail Type 31	\$		\$	
32	6	Each	Beam Guardrail Transition Section Type B Connection	\$		\$	
33	3	Each	Beam Guardrail Anchor Type 4	\$		\$	
34	11	Each	Beam Guardrail Anchor Type 10	\$		\$	
35	2,287.5	L.F.	Raising Existing Beam Guardrail	\$		\$	
36	1	L.S.	Project Temporary Traffic Control		LUMP SUM	\$	
37	12.5	L.F.	New Beam Guardrail Section	\$		\$	
38	329	Each	Underground Utility Verification Pothole	\$		\$	
39	150	C.Y.	Structure Excavation Class B Incl. Haul	\$		\$	
40	20	C.Y.	Gravel Backfill for Foundation Class A	\$		\$	
41	33	C.Y.	Gabion Cribbing	\$		\$	
42	1	L.S.	Trimming and Cleanup		LUMP SUM	\$	
43	2	Each	Mailbox Support Type 1	\$		\$	
44	0	Est.	Reimbursement for Third Party Damage		ESTIMATED		\$0.00
45	1	Calc.	Minor Change		CALCULATED	\$	25,000.00
46	1	L.S.	SPCC Plan		LUMP SUM	\$	
47	0.31	Acre	Seeding and Mulching	\$		\$	
					TOTAL BID	\$	

2019 COUNTY SAFETY PROGRAM PHASE II

SUMMARY OF QUANTITIES

ITEM NO.	STD. ITEM NO.	ITEM DESCRIPTION	TOTAL QUANTITY	UNIT
PREPARATION				
1	0001	MOBILIZATION	LUMP SUM	LUMP SUM
2	0035	CLEARING AND GRUBBING	LUMP SUM	LUMP SUM
3	0050	REMOVAL OF STRUCTURES AND OBSTRUCTIONS	LUMP SUM	LUMP SUM
4	0251	HAZARDOUS MATERIAL EXCAVATION INCL. HAUL	3	C.Y.
5	0260	HAZARDOUS MATERIAL HANDLING AND DISPOSAL	EST.	EST.
GRADING				
6	0300	ROADWAY EXCAVATION	10	C.Y.
7	0310	ROADWAY EXCAVATION INCL. HAUL	600	C.Y.
8	0408	SELECT BORROW INCL. HAUL	388	TON
DRAINAGE				
9	1182	SCHEDULE A CULV. PIPE 18 IN. DIAM.	158	L.F.
10	1247	CL. III REINF. CONC. CULV. PIPE 18 IN. DIAM.	34	L.F.
11	1294	CL. V REINF. CONC. CULV. PIPE 24 IN. DIAM.	72	L.F.
12	2288	PLAIN ST. CULV. PIPE ARCH 0.109 IN. TH. 64 IN. SPAN	8	L.F.
13	3075	TEMPORARY STREAM DIVERSION	LUMP SUM	LUMP SUM
STORM SEWER				
14	3105	CATCH BASIN TYPE 2 48 IN. DIAM.	1	EACH
15	3543	SCHEDULE A STORM SEWER PIPE 24 IN. DIAM.	10	L.F.
STRUCTURE				
16	4025	GRAVEL BACKFILL FOR WALL	35	C.Y.
SURFACING				
17	5100	CRUSHED SURFACING BASE COURSE	2800	TON
18	S.P.	CRUSHED SURFACING TOP COURSE (KEYSTONE)	110	TON
HOT MIX ASPHALT				
19	5875	COMMERCIAL HMA	6	TON
EROSION CONTROL AND ROADSIDE PLANTING				
20	6479	WATTLE	2240	L.F.
TRAFFIC				
21	S.P.	BEAM GUARDRAIL TYPE 1 - 8 FT. LONG POST	156.25	L.F.
22	6747	BEAM GUARDRAIL TYPE 1 - 9 FT. LONG POST	506.25	L.F.
23	6749	BEAM GUARDRAIL TYPE 1 - 11 FT. LONG POST	62.50	L.F.
24	6711	BEAM GUARDRAIL TYPE 31 - 8 FT. LONG POST	862.5	L.F.
25	6712	BEAM GUARDRAIL TYPE 31 - 9 FT. LONG POST	918.75	L.F.
26	6713	BEAM GUARDRAIL TYPE 31 - 11 FT. LONG POST	606.25	L.F.
27	6755	BEAM GUARDRAIL BLOCK	100	EACH
28	S.P.	BEAM GUARDRAIL NON - FLARED TERMINAL	2	EACH
29	6719	BEAM GUARDRAIL TYPE 31 NON - FLARED TERMINAL	11	EACH
30	6751	BEAM GUARDRAIL TYPE 1	43.75	L.F.
31	6757	BEAM GUARDRAIL TYPE 31	150	L.F.
32	6760	BEAM GUARDRAIL TRANSITION SECTION TYPE B CONNECTION	6	EACH
33	6774	BEAM GUARDRAIL ANCHOR TYPE 4	3	EACH
34	6766	BEAM GUARDRAIL ANCHOR TYPE 10	11	EACH
35	6783	RAISING EXISTING BEAM GUARDRAIL	2287.50	L.F.
36	6971	PROJECT TEMPORARY TRAFFIC CONTROL	LUMP SUM	LUMP SUM
37	S.P.	NEW BEAM GUARDRAIL SECTION	12.50	L.F.
38	S.P.	UNDERGROUND UTILITY VERIFICATION POTHOLE	329	EACH

ITEM NO.	STD. ITEM NO.	ITEM DESCRIPTION	TOTAL QUANTITY	UNIT
OTHER ITEMS				
39	7006	STRUCTURE EXCAVATION CLASS B INCL. HAUL	150	C.Y.
40	7011	GRAVEL BACKFILL FOR FOUNDATION CLASS A	20	C.Y.
41	7150	GABION CRIBBING	33	C.Y.
42	7490	TRIMMING AND CLEANUP	LUMP SUM	LUMP SUM
43	7562	MAILBOX SUPPORT TYPE 1	2	EACH
44	7725	REIMBURSEMENT FOR THIRD PARTY DAMAGE	EST.	EST.
45	7728	MINOR CHANGE	CALC	CALC
46	7736	SPCC PLAN	LUMP SUM	LUMP SUM
47	6422	SEEDING AND MULCHING	0.31	ACRE

LEGEND

EXISTING FEATURES	SURVEY FEATURES
CULVERT/STORM SEWER FLOW (DITCH) CENTERLINE EDGE OF ROADWAY GUARDRAIL APPROACH BRIDGE/SIDEWALK FOG LINE FENCE SHOULDER STREAM BUILDING SIGN MAILBOX	RIGHT OF WAY PROPERTY LINE PERMANENT SLOPE EASEMENT TEMPORARY CONSTRUCTION EASEMENT ROGERS ROAD PRESCRIPTIVE RIGHT OF WAY
NEW CONSTRUCTION FEATURES	
CALLOUT CULVERT/ CULVERT EXTENSION LANDINGS & FILL SLOPES GUARDRAIL FILL CUT WATTLE	

GENERAL NOTES

- AT ALL TIMES FOR THE DURATION OF THE PROJECT, THE CONTRACTOR SHALL HAVE ON HAND, THE PROJECT CONTRACT PROVISIONS AND PLANS, AND A CURRENT EDITION OF THE WASHINGTON STATE DEPARTMENT OF TRANSPORTATION STANDARD SPECIFICATIONS FOR ROAD, BRIDGE, AND MUNICIPAL CONSTRUCTION (M 41-10).
- THE CONTRACTOR WILL COORDINATE, COOPERATE AND ASSIST IN THE INSPECTION PROCESSES THAT IS REQUIRED FOR THE COMPLETION OF THE PROJECT.
- AT NO COST TO THE CONTRACTOR, ALL NECESSARY CONSTRUCTION SURVEY REQUESTS SHALL BE GIVEN A 3 DAY IN ADVANCE NOTICE. HOWEVER, THE CONTRACTOR WILL BE RESPONSIBLE FOR REPLACING NEEDED SURVEY STAKES DESTROYED THROUGH NORMAL OPERATIONS, NEGLIGENCE, OR INATTENTION.
- AT THE END OF EACH DAY, THE CONTRACTOR SHALL CLEAN UP THE PROJECT AREA AND LEAVE IT IN A NEAT AND SECURED MANNER. UPON COMPLETION, THE CONTRACTOR SHALL LEAVE THE PROJECT FREE OF DEBRIS AND UNUSED MATERIAL.
- THE CONTRACTOR IS TO MAINTAIN INGRESS AND EGRESS FROM THE PROJECT SITE, AND PRIVATE PROPERTY DRIVEWAYS DURING CONSTRUCTION.
- AT A MINIMUM, THE CONTRACTOR IS TO MAINTAIN ALTERNATING ONE WAY TRAFFIC CONTROL UNLESS APPROVED TRAFFIC CONTROL PLAN ALLOWS OTHERWISE.

5/11/2021 10:14 AM

S:\Engineer\Design\2019 COUNTY SAFETY PROGRAM\SUMMARY OF QUANTITIES & LEGEND.dwg

Lewis County
 Department of Public Works
 2025 NE KRESKY AVE.
 CHEHALIS WA 98532
 PHONE # (360) 740-1123
 FAX # (360) 740-2719

DESIGNED BY : DJC
 DRAWN BY : KLP
 CHECKED BY :
 DATE :

NO.	DATE	REVISION	BY	APP.
1	5/11/2021	ADDED SEEDING AND MULCHING BID ITEM	KLP	GRS
1	5/11/2021	CHANGED QUANTITY OF SELECT BORROW FROM 390 TO 388	KLP	GRS

2019 COUNTY SAFETY PROGRAM PHASE II

FEDERAL-AID NO: HSIP-000S (553)
 COUNTY ROAD PROJECT NO: 2191B
 SUMMARY OF QUANTITIES &
 LEGEND


SHEET
2
 OF
4



Donald J. Carney, P.E.
 Senior Engineer/Design
 Date: 2/17/21




5/11/2021 1:07 PM

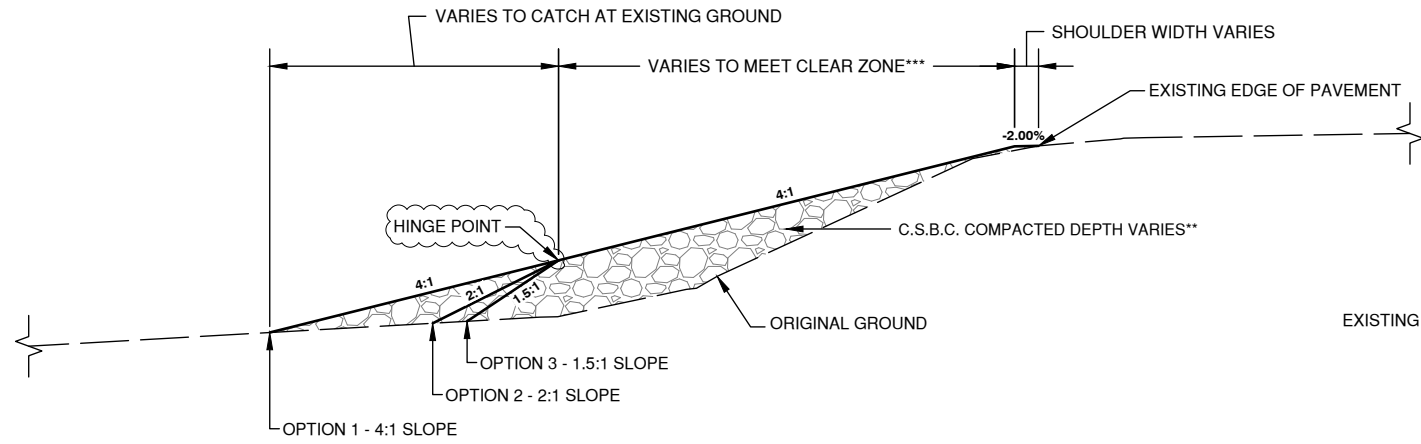

FILL SLOPE TYPICAL SECTION A-A (1-3)
NOT TO SCALE


*** CLEAR ZONE LENGTHS SHALL BE 10.00' OFF OF THE EDGE OF PAVEMENT UNLESS SHOWN OTHERWISE.

NOTE: CRUSHED SURFACING TOP COURSE (KEYSTONE) SHALL BE PLACED PER CONTRACT SPECIAL PROVISION 4-04.3(6). KEYSTONE EXTENTS SHALL BE 10' BEYOND EDGE OF ASPHALT.

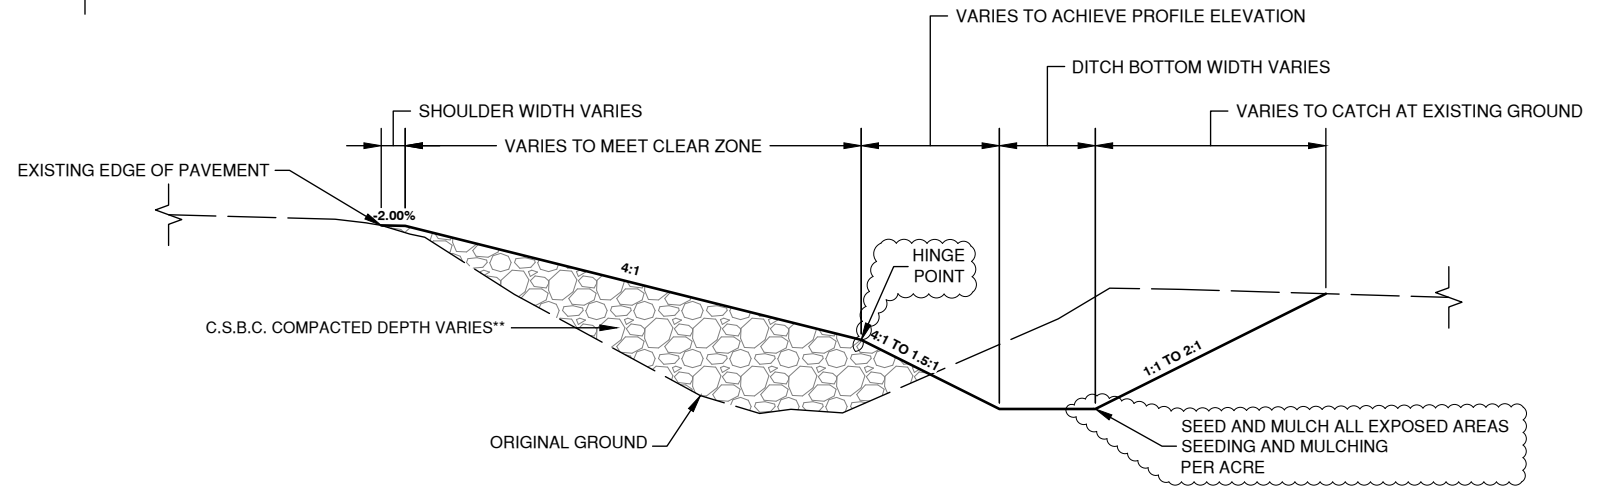


FILL SLOPE TYPICAL SECTION B-B
NOT TO SCALE

NOTE: CRUSHED SURFACING TOP COURSE (KEYSTONE) SHALL BE PLACED PER CONTRACT SPECIAL PROVISION 4-04.3(6). KEYSTONE EXTENTS SHALL BE 10' BEYOND EDGE OF ASPHALT.

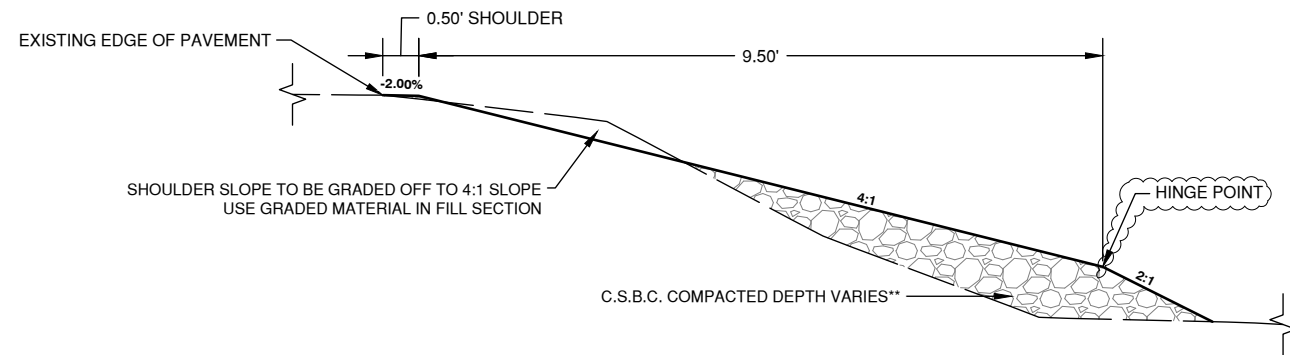

SHOULDER GRADING TYPICAL SECTION
NOT TO SCALE

NOTE: CRUSHED SURFACING TOP COURSE (KEYSTONE) SHALL BE PLACED PER CONTRACT SPECIAL PROVISION 4-04.3(6). KEYSTONE EXTENTS SHALL BE 10' BEYOND EDGE OF ASPHALT.

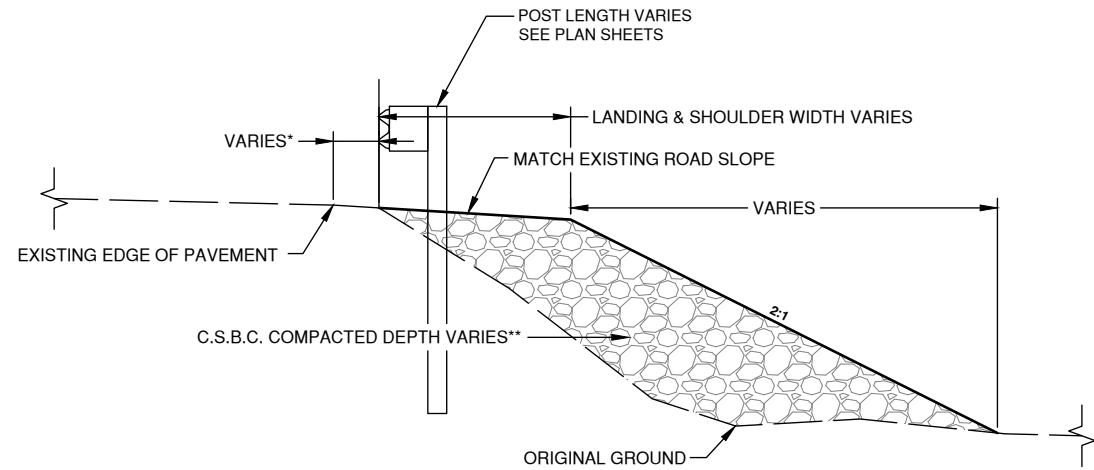

GUARDRAIL TYPICAL SECTION
NOT TO SCALE

* 0.5' MIN @ ALL TYPE 31 GUARDRAIL LOCATIONS

NOTE: POST LENGTHS ARE LISTED FOR ESTIMATE PURPOSES ONLY. ACTUAL LENGTH OF POSTS WILL BE DICTATED BY ACTUAL FIELD CONDITIONS AND BEAM GUARDRAIL POST INSTALLATION DETAIL ON SHEET 4 OF 4. SHOULDER WIDENING MAY BE REQUIRED AS SHOWN IN THE PLANS TO MEET BEAM GUARDRAIL POST INSTALLATION DETAIL ON SHEET 4 OF 4.

** ALL SITES SHALL USE C.S.B.C. EXCEPT FOR THE FOLLOWING SITES.

- CENTRALIA ALPHA ROAD SITE 1 (APPROACH TO BRIDGE)

THEY SHALL USE SELECT BORROW UP TO THE HINGE POINT. SEED AND MULCH ALL EXPOSED AREAS AND SELECT BORROW FROM APPROACH TO BRIDGE.

SEED AND MULCH ALL EXPOSED AREAS SEEDING AND MULCHING PER ACRE

S:\Engineer\Design\2019 COUNTY SAFETY PROGRAM\TYPICAL SECTION SHEETS.dwg

Lewis County
2025 N. E. KRESKY AVE.
CHEHALIS WA 98532
PHONE # (360) 740-1123
FAX # (360) 740-2719
Department of Public Works

DESIGNED BY : DJC
DRAWN BY : KLP
CHECKED BY :
DATE :

NO.	DATE	REVISION	BY	APP.
1	5/11/2021	ADDED SEEDING AND MULCHING NOTE	KLP	GRS
1	5/11/2021	DELETED "REYNOLDS ROAD" FROM SELECT BORROW NOTE	KLP	GRS
1	5/11/2021	CHANGED SELECT BORROW NOTE	KLP	GRS
1	5/11/2021	ADDED "HINGE POINT" LEADER	KLP	GRS

**2019 COUNTY SAFETY PROGRAM
PHASE II**

FEDERAL-AID NO:
COUNTY ROAD PROJECT NO: 2191B

TYPICAL SECTIONS

SHEET
3
OF
4



Donald J. Carney, P.E.
Senior Engineer/Design

Date: 2/17/21



CENTRALIA ALPHA ROAD

SUMMARY OF QUANTITIES

ITEM NO.	STD. ITEM NO.	ITEM DESCRIPTION	TOTAL QUANTITY	UNIT
PREPARATION				
1	0001	MOBILIZATION	LUMP SUM	LUMP SUM
2	0035	CLEARING AND GRUBBING	LUMP SUM	LUMP SUM
3	0050	REMOVAL OF STRUCTURES AND OBSTRUCTIONS	LUMP SUM	LUMP SUM
4	0251	HAZARDOUS MATERIAL EXCAVATION INCL. HAUL	0	C.Y.
5	0260	HAZARDOUS MATERIAL HANDLING AND DISPOSAL	EST.	EST.
GRADING				
6	0300	ROADWAY EXCAVATION	2	C.Y.
7	0310	ROADWAY EXCAVATION INCL. HAUL	65	C.Y.
8	0408	SELECT BORROW INCL. HAUL	388	TON
DRAINAGE				
9	1182	SCHEDULE A CULV. PIPE 18 IN. DIAM.	0	L.F.
10	1247	CL. III REINF. CONC. CULV. PIPE 18 IN. DIAM.	0	L.F.
11	1294	CL. V REINF. CONC. CULV. PIPE 24 IN. DIAM.	40	L.F.
12	2288	PLAIN ST. CULV. PIPE ARCH 0.109 IN. TH. 64 IN. SPAN	0	L.F.
13	3075	TEMPORARY STREAM DIVERSION	LUMP SUM	LUMP SUM
STORM SEWER				
14	3105	CATCH BASIN TYPE 2 48 IN. DIAM.	1	EACH
15	3543	SCHEDULE A STORM SEWER PIPE 24 IN. DIAM.	10	L.F.
STRUCTURE				
16	4025	GRAVEL BACKFILL FOR WALL	0	C.Y.
SURFACING				
17	5100	CRUSHED SURFACING BASE COURSE	997	TON
18	S.P.	CRUSHED SURFACING TOP COURSE (KEYSTONE)	50	TON
HOT MIX ASPHALT				
19	5875	COMMERCIAL HMA	0	TON
EROSION CONTROL AND ROADSIDE PLANTING				
20	6479	WATTLE	1785	L.F.
TRAFFIC				
21	S.P.	BEAM GUARDRAIL TYPE 1 - 8 FT. LONG POST	0	L.F.
22	6747	BEAM GUARDRAIL TYPE 1 - 9 FT. LONG POST	0	L.F.
23	6749	BEAM GUARDRAIL TYPE 1 - 11 FT. LONG POST	0	L.F.
24	6711	BEAM GUARDRAIL TYPE 31 - 8 FT. LONG POST	150	L.F.
25	6712	BEAM GUARDRAIL TYPE 31 - 9 FT. LONG POST	262.50	L.F.
26	6713	BEAM GUARDRAIL TYPE 31 - 11 FT. LONG POST	462.50	EACH
27	6755	BEAM GUARDRAIL BLOCK	0	EACH
28	S.P.	BEAM GUARDRAIL NON - FLARED TERMINAL	0	EACH
29	6719	BEAM GUARDRAIL TYPE 31 NON - FLARED TERMINAL	4	EACH
30	6751	BEAM GUARDRAIL TYPE 1	0	L.F.
31	6757	BEAM GUARDRAIL TYPE 31	0	L.F.
32	6760	BEAM GUARDRAIL TRANSITION SECTION TYPE B CONNECTION	4	EACH
33	6774	BEAM GUARDRAIL ANCHOR TYPE 4	0	EACH
34	6766	BEAM GUARDRAIL ANCHOR TYPE 10	2	EACH
35	6783	RAISING EXISTING BEAM GUARDRAIL	1587.50	L.F.
36	6971	PROJECT TEMPORARY TRAFFIC CONTROL	LUMP SUM	LUMP SUM
37	S.P.	NEW BEAM GUARDRAIL SECTION	0	L.F.
38	S.P.	UNDERGROUND UTILITY VERIFICATION POTHOLE	86	EACH

ITEM NO.	STD. ITEM NO.	ITEM DESCRIPTION	TOTAL QUANTITY	UNIT
OTHER ITEMS				
39	7006	STRUCTURE EXCAVATION CLASS B INCL. HAUL	30.50	C.Y.
40	7011	GRAVEL BACKFILL FOR FOUNDATION CLASS A	0	C.Y.
41	7150	GABION CRIBBING	0	C.Y.
42	7490	TRIMMING AND CLEANUP	LUMP SUM	LUMP SUM
43	7562	MAILBOX SUPPORT TYPE 1	0	EACH
44	7725	REIMBURSEMENT FOR THIRD PARTY DAMAGE	EST.	EST.
45	7728	MINOR CHANGE	CALC	CALC
46	7736	SPCC PLAN	LUMP SUM	LUMP SUM
47	6422	SEEDING AND MULCHING	0.06	ACRE



VICINITY MAP
NOT TO SCALE

5/11/2021 10:16 AM

S:\Engineer\Design\2019 COUNTY SAFETY PROGRAM\SUMMARY OF QUANTITIES & LEGEND.dwg

Lewis County
Department of Public Works
2025 NE KRESKY AVE.
CHEHALIS WA 98532
PHONE # (360) 740-1123
FAX # (360) 740-2719

DESIGNED BY : DJC
DRAWN BY : KLP
CHECKED BY :
DATE :

NO.	DATE	REVISION	BY	APP.
1	5/11/2021	ADDED SEEDING AND MULCHING BID ITEM	KLP	GRS

2019 COUNTY SAFETY PROGRAM PHASE II

FEDERAL-AID NO: HSIP-000S (553)
COUNTY ROAD PROJECT NO: 2191B
CENTRALIA ALPHA ROAD
SUMMARY OF QUANTITIES

SHEET
CA1
OF
CA10




Donald J. Carney, P.E.
Senior Engineer/Design
Date: 2/17/21



5/11/2021 10:18 AM

TOWNSHIP 14/15 NORTH, RANGE 2 WEST W.M.

ALL QUANTITIES FOR CRUSHED SURFACING BASE COURSE INCLUDED IN MAINLINE CLEAR LIMITS AT TOP OF PROPOSED DITCH BACKSLOPE OR TOE OF FILL SLOPE SEWER LINE NOT LOCATED

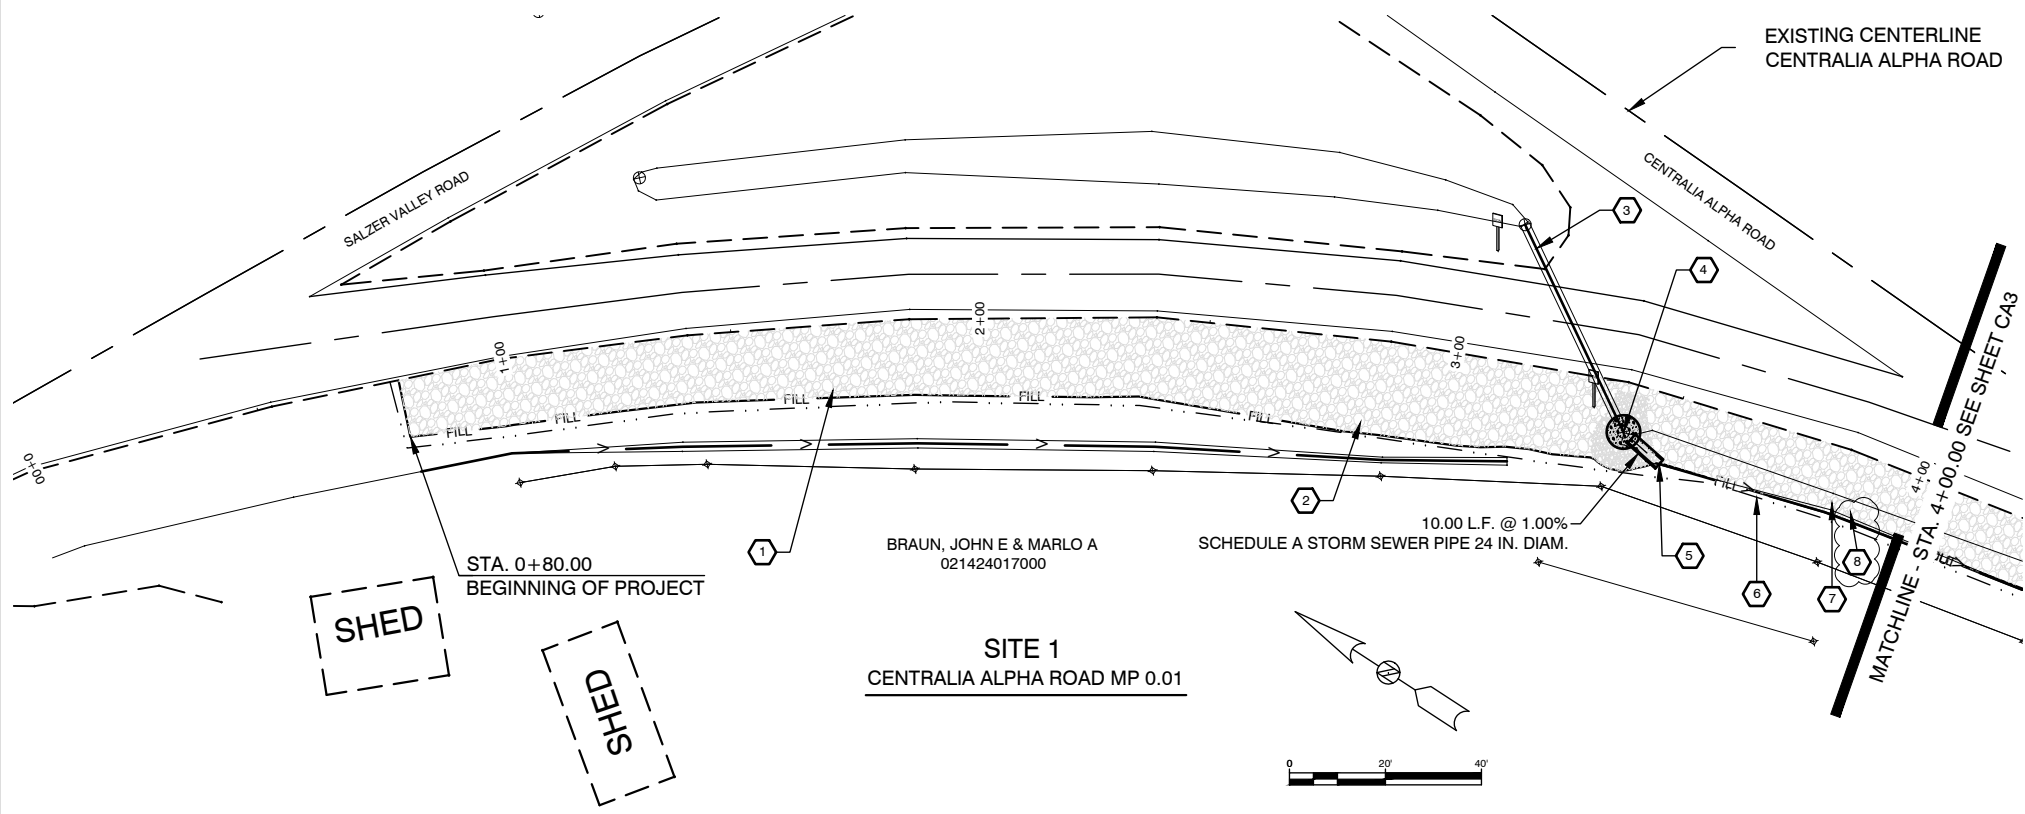


CONSTRUCTION NOTES


- 1 STA. 0+80.00 TO STA. 2+80.00 CONSTRUCT EMBANKMENT SEE FILL SLOPE TYPICAL SECTION A-A (OPTION 2) ON SHEET 3 OF 4
- 2 STA. 2+80.00 TO STA. 3+40.12 CONSTRUCT EMBANKMENT SEE FILL SLOPE TYPICAL SECTION A-A (OPTION 1) ON SHEET 3 OF 4
- 3 EXISTING 18" CONCRETE CULVERT TO REMAIN
- 4 STA. 3+40.12, 10.24' RIGHT (DISTANCE MEASURED TO CENTER OF BASIN) CONSTRUCT CATCH BASIN TYPE 2 - 48 IN. DIAM., WITH CIRCULAR FRAME (RING) AND COVER SEE WSDOT STANDARD PLAN CATCH BASIN TYPE 2 48 IN DIAM., B-10.20 AND CIRCULAR FRAME (RING) AND COVER, B-30.70 SEE CATCH BASIN TYPICAL SECTION ON SHEET CA5 OF CA10 6 C.Y. STRUCTURE EXCAVATION CLASS B INCL. HAUL 25 TON CRUSHED SURFACING BASE COURSE
- 5 STA. 3+42.09 CONSTRUCT SCHEDULE A STORM SEWER PIPE 24" DIAM., 10 L.F. SEE WSDOT STANDARD PLAN B-60.20 INLET INVERT EL. = 180.15 (STA. 3+42.09) 11.15' RT OUTLET INVERT EL. = 180.05 (STA. 3+49.20) 14.47' RT SEE CENTRALIA ALPHA ROAD CULVERT AND BASIN DETAIL ON THIS SHEET 0.5 C.Y. STRUCTURE EXCAVATION CLASS B INCL. HAUL

CONSTRUCTION NOTES


- 6 WATTLE 1060 L.F.
- 7 STA. 3+42.12 TO STA. 10+64.11 CONSTRUCT EMBANKMENT SEE FILL SLOPE TYPICAL SECTION B-B ON SHEET 3 OF 4
- 8 SEED AND MULCH ALL EXPOSED AREAS STA. 3+87.00 TO STA. 10+64.11 (SEEDING AND MULCHING) 0.06 ACRES

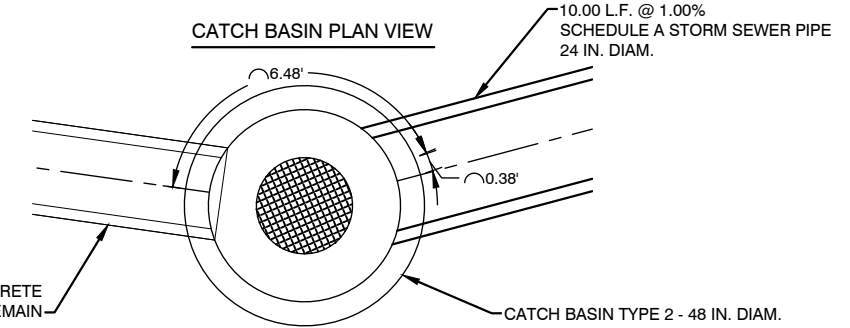

CENTRALIA ALPHA ROAD EDGE OF PAVEMENT RIGHT

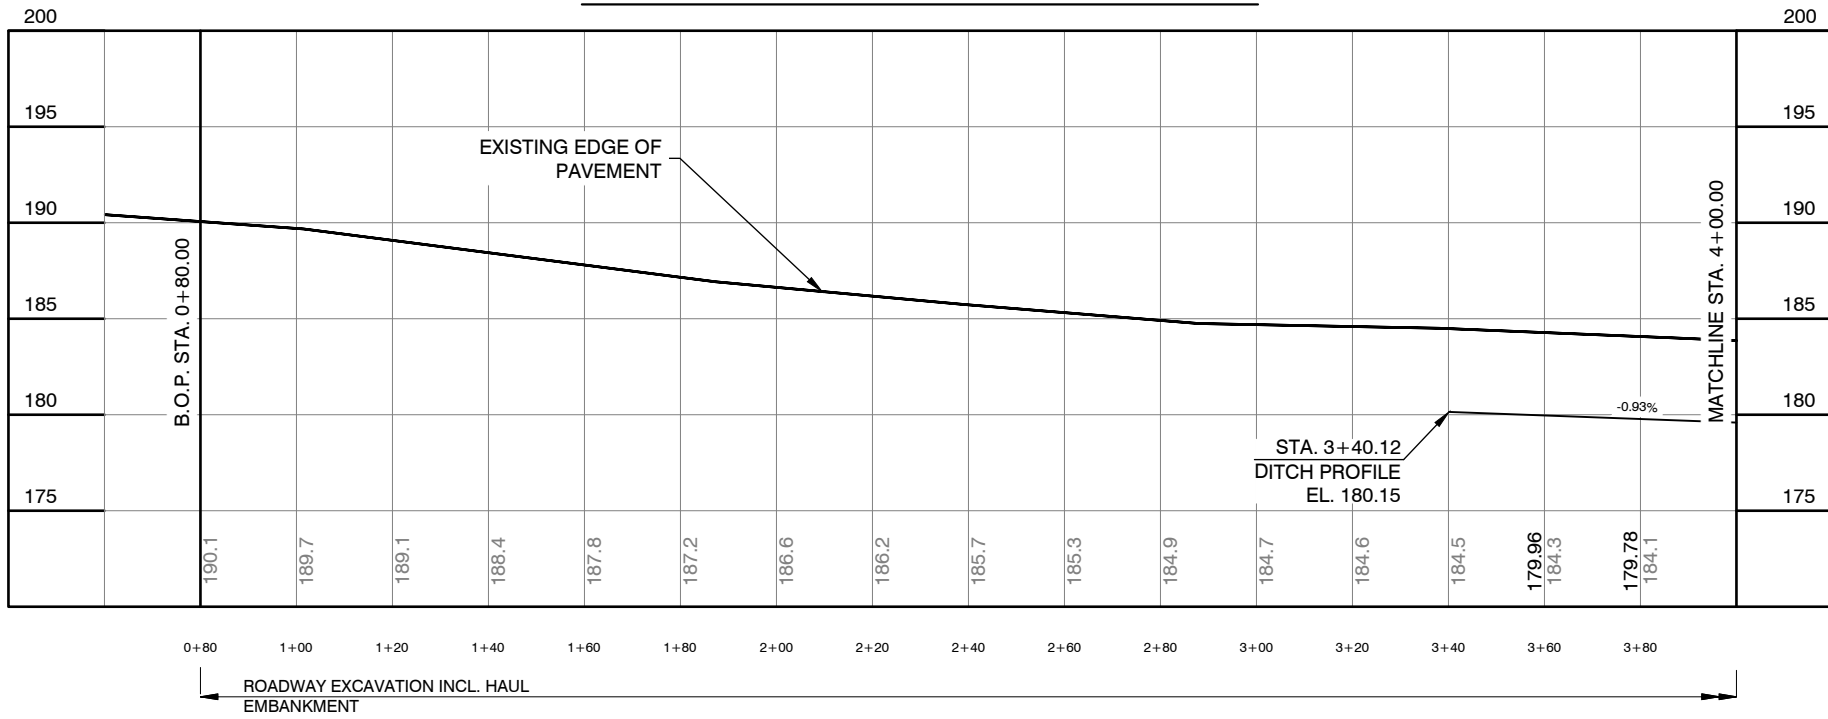

CENTRALIA ALPHA ROAD CULVERT AND BASIN

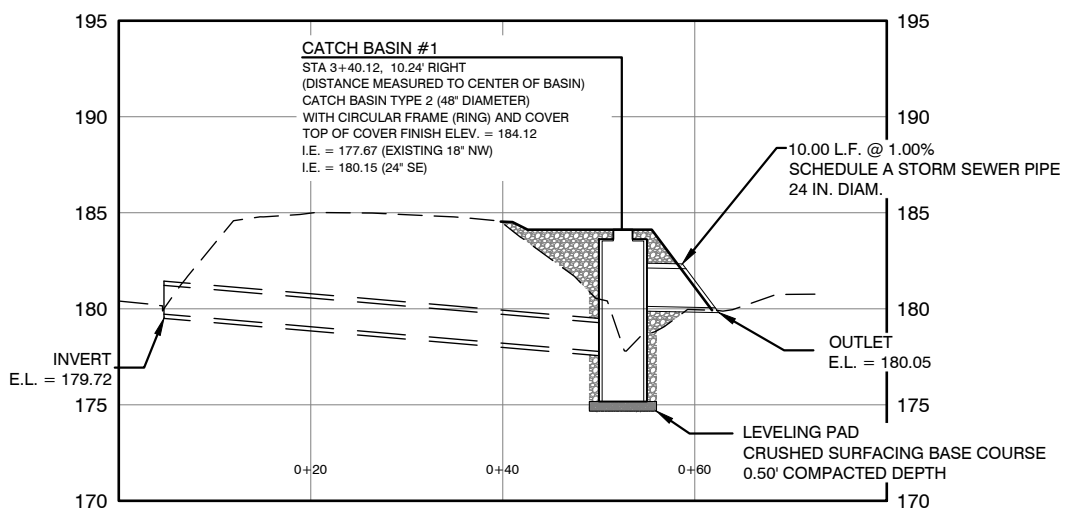

VERTICAL: 1" = 5'
SCALE IS FOR FULL SIZE SHEETS

S:\Engineer\Design\2019 COUNTY SAFETY PROGRAM\Centralia - Alpha (HSIP)\CEN ALPHA MP 0.05 DESIGN NEW.dwg

Lewis County
2025 N. E. KRESKY AVE.
CHEHALIS WA 98532
PHONE # (360) 740-1123
FAX # (360) 740-2719
Department of Public Works

DESIGNED BY : DJC
DRAWN BY : KLP
CHECKED BY :
DATE :

NO.	DATE	REVISION	BY	APP.
1	5/11/2021	ADDED SEEDING AND MULCHING NOTE	KLP	GRS
1	5/11/2021	CHANGED TITLE TO MATCH OTHER SHEETS	KLP	GRS

**2019 COUNTY SAFETY PROGRAM
PHASE II**

FEDERAL-AID NO: HSIP-000S (553)
COUNTY ROAD PROJECT NO: 2191B
CENTRALIA ALPHA ROAD SITE 1

SHEET
CA2
OF
CA10



Donald J. Carney, P.E.
Senior Engineer/Design
Date: 2/17/21




TOWNSHIP 14/15 NORTH, RANGE 2 WEST W.M.

ALL QUANTITIES FOR CRUSHED SURFACING BASE COURSE INCLUDED IN MAINLINE CLEAR LIMITS AT TOP OF PROPOSED DITCH BACKSLOPE OR TOE OF FILL SLOPE SEWER LINE NOT LOCATED


CONSTRUCTION NOTES

- 1 STA. 3+40.12 TO STA. 10+64.11 CONSTRUCT EMBANKMENT SEE FILL SLOPE TYPICAL SECTION B-B ON SHEET 3 OF 4
- 2 CONSTRUCT CLASS IV REINF. CONC. CULV. PIPE 24 IN. DIAM., 40 L.F. TO BE STAKED IN THE FIELD BY THE ENGINEER INLET INVERT E.L. = 177.30 (STA. 6+49.21) 16.36' RIGHT OUTLET INVERT E.L. = 176.99 (STA. 6+88.60) 14.99' RIGHT 30 TON CRUSHED SURFACING BASE COURSE 1 C.Y. STRUCTURE EXCAVATION CLASS B INCL. HAUL
- 3 STA. 6+68.50 CONSTRUCT APPROACH 23' RT END OF APPROACH TO MATCH EXISTING GROUND TOTAL WIDTH AT END OF APPROACH = 19.54' 30 TON CRUSHED SURFACING BASE COURSE
- 4 TEMPORARY CONSTRUCTION EASEMENT
- 5 REMOVE EXISTING CULVERT 23 C.Y. STRUCTURE EXCAVATION CLASS B INCL. HAUL 43 TON CRUSHED SURFACING BASE COURSE
- 6 SEED AND MULCH ALL EXPOSED AREAS STA. 3+87.00 TO STA. 10+64.11 SEEDING AND MULCHING 0.06 ACRES

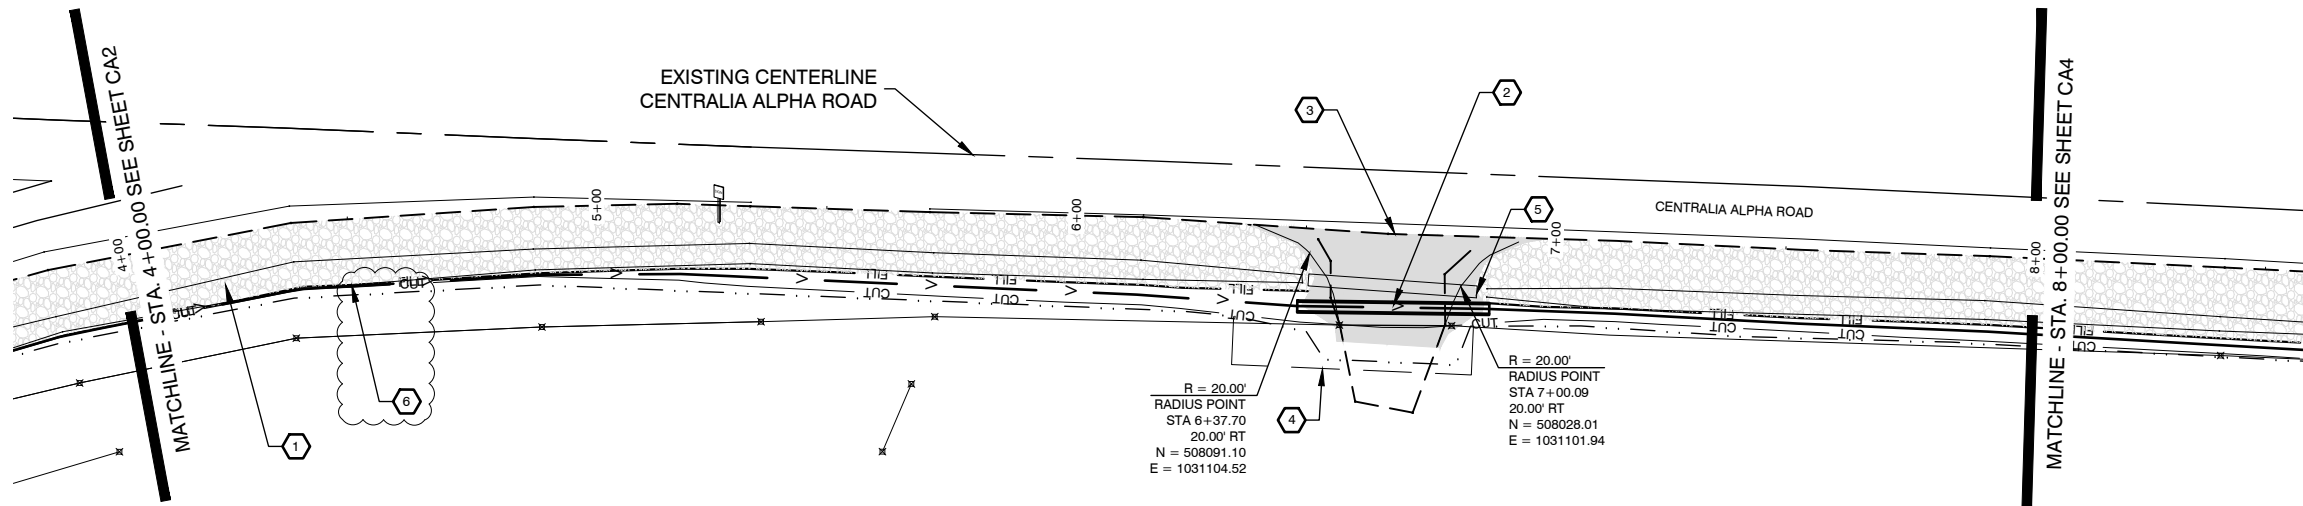


SITE 1
CENTRALIA ALPHA ROAD MP 0.01

BRAUN, JOHN E & MARLO A
021424017000

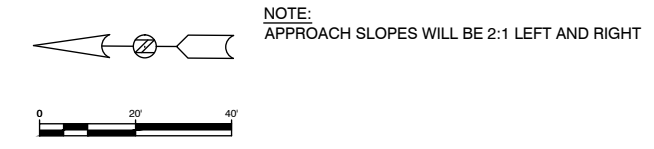


NOTE:
APPROACH SLOPES WILL BE 2:1 LEFT AND RIGHT

CENTRALIA ALPHA ROAD EDGE OF PAVEMENT RIGHT

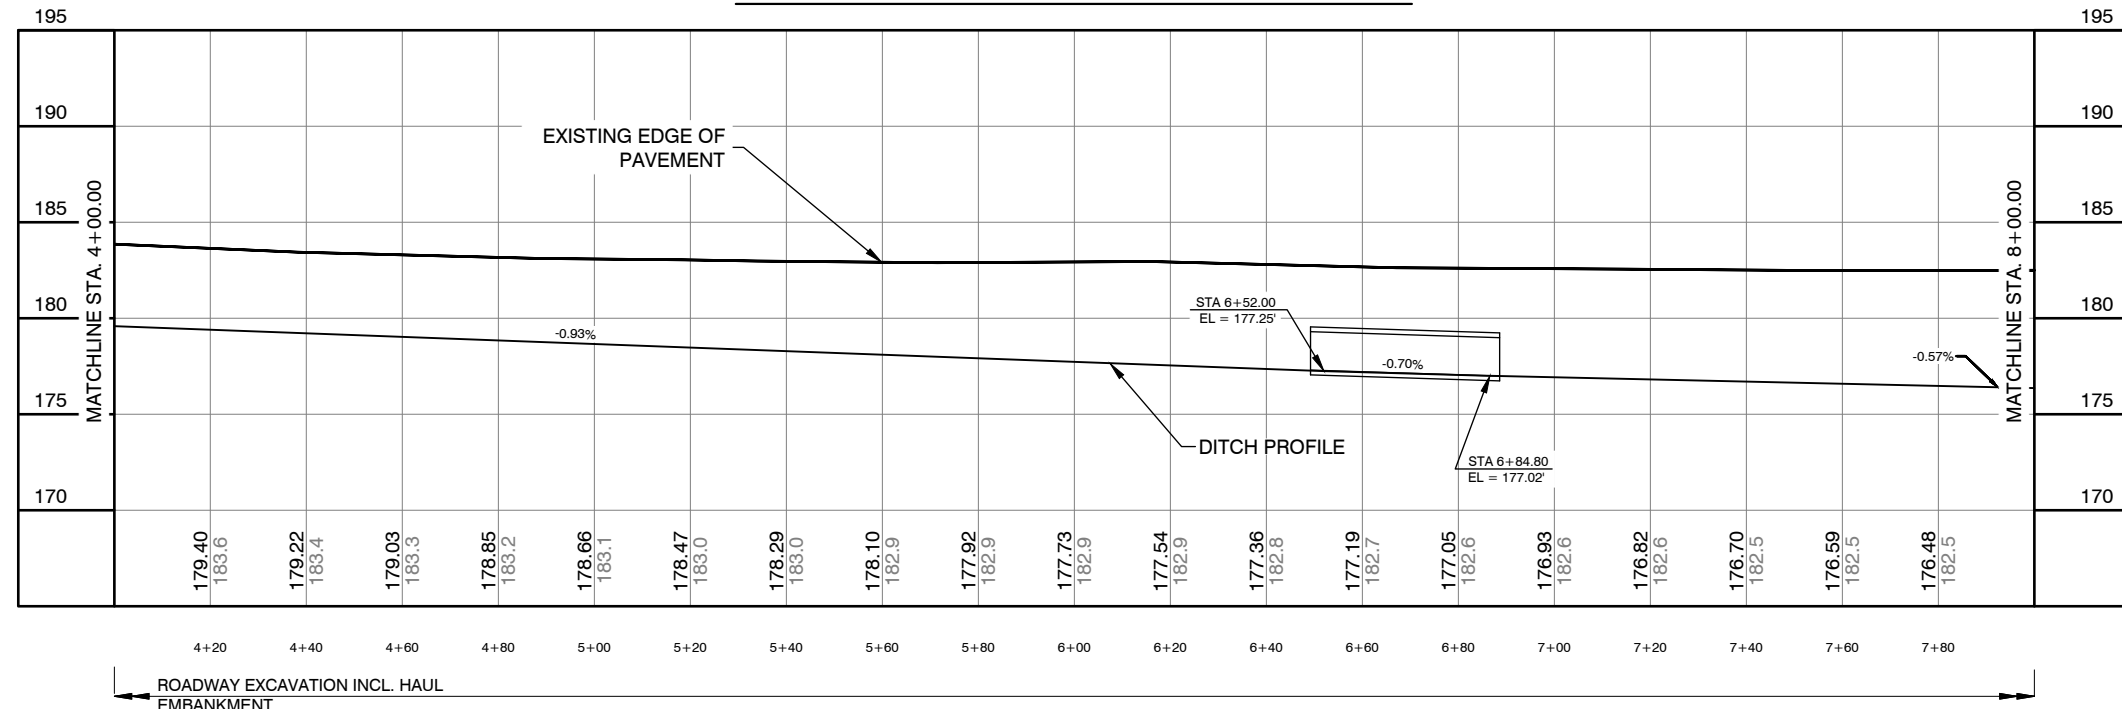

FIELD APPROACH STA 6+68.50

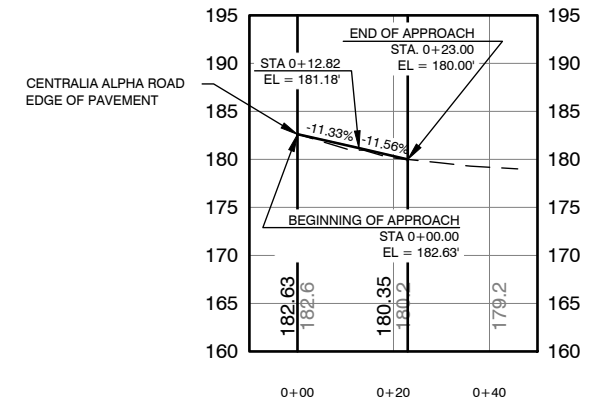

VERTICAL: 1" = 5'
SCALE IS FOR FULL SIZE SHEETS

S:\Engineer\Design\2019 COUNTY SAFETY PROGRAM\Centralia - Alpha (HSIP)\CEN ALPHA MP 0.05 DESIGN NEW.dwg 5/11/2021 10:20 AM

Lewis County
Department of Public Works
2025 N. E. KRESKY AVE.
CHEHALIS WA 98532
PHONE # (360) 740-1123
FAX # (360) 740-2719

DESIGNED BY : DJC
DRAWN BY : KLP
CHECKED BY :
DATE :

NO.	DATE	REVISION	BY	APP.
1	5/11/2021	ADDED SEEDING AND MULCHING NOTE	KLP	GRS
1	5/11/2021	CHANGED TITLE TO MATCH OTHER SHEETS	KLP	GRS

**2019 COUNTY SAFETY PROGRAM
PHASE II**

FEDERAL-AID NO: HSIP-000S (553)
COUNTY ROAD PROJECT NO: 2191B
CENTRALIA ALPHA ROAD SITE 1

SHEET
CA3
OF
CA10




Donald J. Carney, P.E.
Senior Engineer/Design
Date: 2/17/21




5/11/2021 10:21 AM

TOWNSHIP 14/15 NORTH, RANGE 2 WEST W.M.


ALL QUANTITIES FOR CRUSHED SURFACING BASE COURSE INCLUDED IN MAINLINE CLEAR LIMITS AT TOP OF PROPOSED DITCH BACKSLOPE OR TOE OF FILL SLOPE SEWER LINE NOT LOCATED

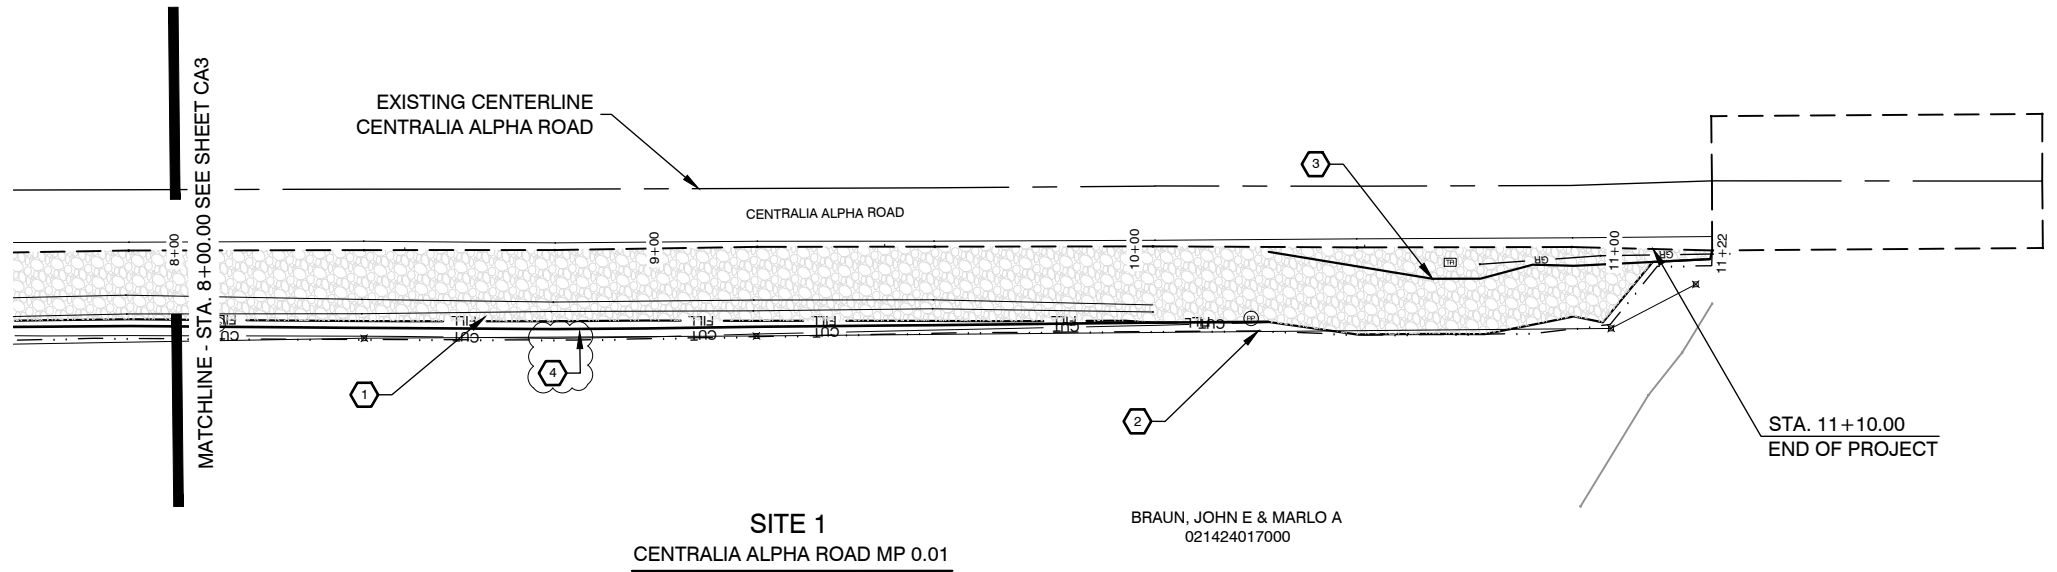

- CONSTRUCTION NOTES**
- 1 STA. 3+40.12 TO STA. 10+64.11 CONSTRUCT EMBANKMENT
SEE FILL SLOPE TYPICAL SECTION B-B ON SHEET 3 OF 4
 - 2 STA. 10+30.00
END V-BOTTOM DITCH
 - 3 STA. 10+64.11 TO STA. 11+10.00 CONSTRUCT LANDING FOR EXISTING GUARDRAIL
SEE GUARDRAIL TYPICAL SECTION ON SHEET 3 OF 4
 - 4 SEED AND MULCH ALL EXPOSED AREAS
STA. 3+87.00 TO STA. 10+64.11
SEEDING AND MULCHING
0.06 ACRES

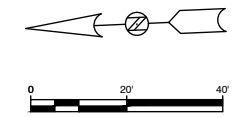

CENTRALIA ALPHA ROAD EDGE OF PAVEMENT RIGHT

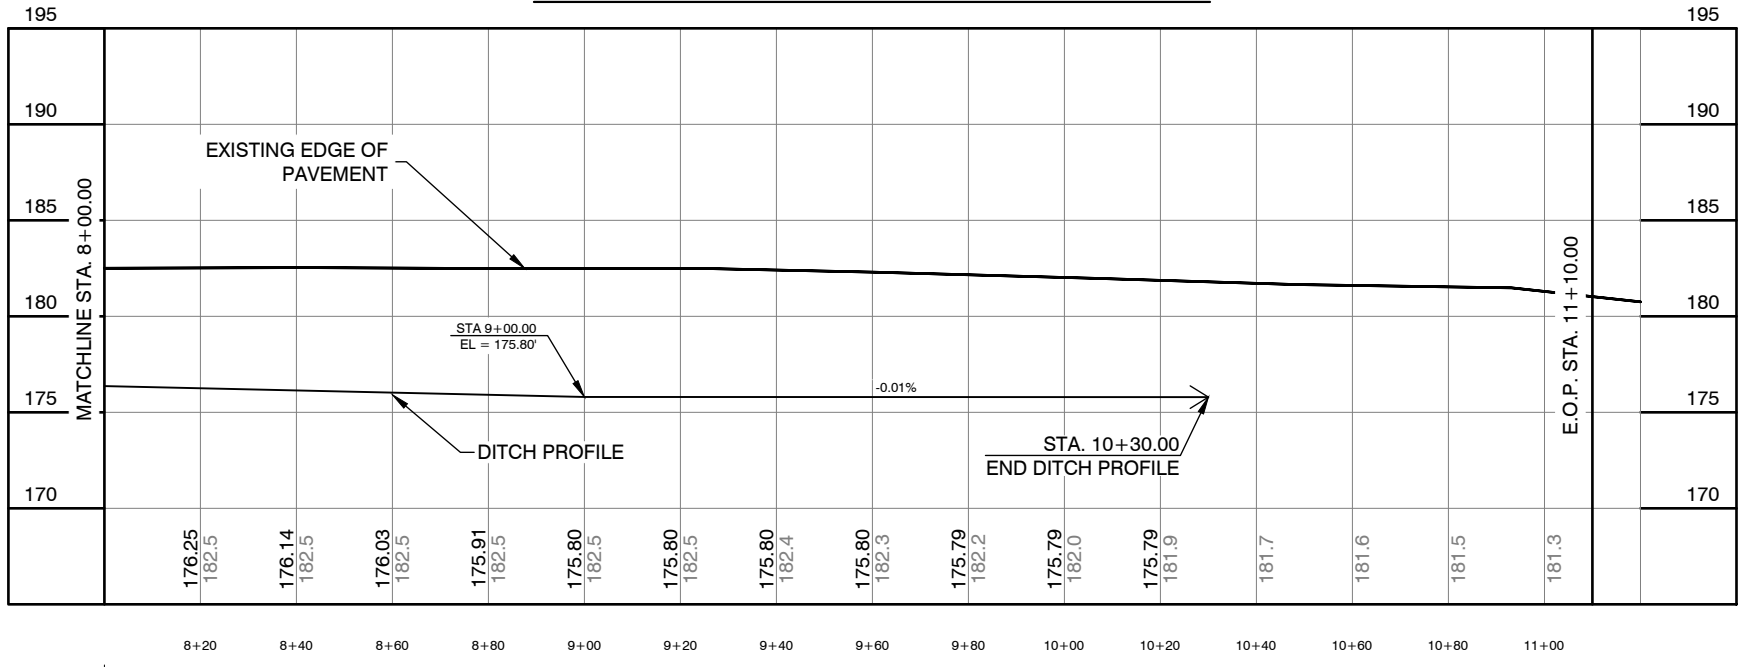

ROADWAY EXCAVATION INCL. HAUL EMBANKMENT

65 C.Y.
692 C.Y.

(417.58 C.Y. X 1.65 = 690 TONS C.S.B.C.)
(254.87 C.Y. X 1.50 = 388 TONS SELECT BORROW)
(19.07 C.Y. X 1.85 = 35 TONS C.S.T.C. (KEYSTONE))

S:\Engineer\Design\2019 COUNTY SAFETY PROGRAM\Centralia - Alpha (HSIP)\CEN ALPHA MP 0.05 DESIGN NEW.dwg

Lewis County
Department of Public Works

2025 N. E. KRESKY AVE.
CHEHALIS WA 98532
PHONE # (360) 740-1123
FAX # (360) 740-2719

DESIGNED BY : DJC
DRAWN BY : KLP
CHECKED BY :
DATE :

NO.	DATE	REVISION	BY	APP.
1	5/11/2021	ADDED SEEDING AND MULCHING NOTE	KLP	GRS
1	5/11/2021	CHANGED TITLE TO MATCH OTHER SHEETS	KLP	GRS

**2019 COUNTY SAFETY PROGRAM
PHASE II**

FEDERAL-AID NO: HSIP-000S (553)
COUNTY ROAD PROJECT NO: 2191B

CENTRALIA ALPHA ROAD SITE 1

SHEET
**CA4
OF
CA10**

CALL 48 HOURS BEFORE YOU DIG
1-800-424-5555
"It's the Law"
Utilities Underground Location Center

Donald J. Carney, P.E.
Senior Engineer/Design

Date: 2/17/21




ROGERS ROAD

SUMMARY OF QUANTITIES

ITEM NO.	STD. ITEM NO.	ITEM DESCRIPTION	TOTAL QUANTITY	UNIT
PREPARATION				
1	0001	MOBILIZATION	LUMP SUM	LUMP SUM
2	0035	CLEARING AND GRUBBING	LUMP SUM	LUMP SUM
3	0050	REMOVAL OF STRUCTURES AND OBSTRUCTIONS	LUMP SUM	LUMP SUM
4	0251	HAZARDOUS MATERIAL EXCAVATION INCL. HAUL	0	C.Y.
5	0260	HAZARDOUS MATERIAL HANDLING AND DISPOSAL	EST.	EST.
GRADING				
6	0300	ROADWAY EXCAVATION	7	C.Y.
7	0310	ROADWAY EXCAVATION INCL. HAUL	535	C.Y.
8	0408	SELECT BORROW INCL. HAUL	0	TON
DRAINAGE				
9	1182	SCHEDULE A CULV. PIPE 18 IN. DIAM.	7	L.F.
10	1247	CL. III REINF. CONC. CULV. PIPE 18 IN. DIAM.	0	L.F.
11	1294	CL. V REINF. CONC. CULV. PIPE 24 IN. DIAM.	32	L.F.
12	2288	PLAIN ST. CULV. PIPE ARCH 0.109 IN. TH. 64 IN. SPAN	8	L.F.
13	3075	TEMPORARY STREAM DIVERSION	LUMP SUM	LUMP SUM
STORM SEWER				
14	3105	CATCH BASIN TYPE 2 48 IN. DIAM.	0	EACH
15	3543	SCHEDULE A STORM SEWER PIPE 24 IN. DIAM.	0	L.F.
STRUCTURE				
16	4025	GRAVEL BACKFILL FOR WALL	23	C.Y.
SURFACING				
17	5100	CRUSHED SURFACING BASE COURSE	805	TON
18	S.P.	CRUSHED SURFACING TOP COURSE (KEYSTONE)	50	TON
HOT MIX ASPHALT				
19	5875	COMMERCIAL HMA	0	TON
EROSION CONTROL AND ROADSIDE PLANTING				
20	6479	WATTLE	0	L.F.
TRAFFIC				
21	S.P.	BEAM GUARDRAIL TYPE 1 - 8 FT. LONG POST	0	L.F.
22	6747	BEAM GUARDRAIL TYPE 1 - 9 FT. LONG POST	0	L.F.
23	6749	BEAM GUARDRAIL TYPE 1 - 11 FT. LONG POST	0	L.F.
24	6711	BEAM GUARDRAIL TYPE 31 - 8 FT. LONG POST	0	L.F.
25	6712	BEAM GUARDRAIL TYPE 31 - 9 FT. LONG POST	0	L.F.
26	6713	BEAM GUARDRAIL TYPE 31 - 11 FT. LONG POST	0	EACH
27	6755	BEAM GUARDRAIL BLOCK	0	EACH
28	S.P.	BEAM GUARDRAIL NON - FLARED TERMINAL	0	EACH
29	6719	BEAM GUARDRAIL TYPE 31 NON - FLARED TERMINAL	0	EACH
30	6751	BEAM GUARDRAIL TYPE 1	0	L.F.
31	6757	BEAM GUARDRAIL TYPE 31	0	L.F.
32	6760	BEAM GUARDRAIL TRANSITION SECTION TYPE B CONNECTION	0	EACH
33	6774	BEAM GUARDRAIL ANCHOR TYPE 4	0	EACH
34	6766	BEAM GUARDRAIL ANCHOR TYPE 10	0	EACH
35	6783	RAISING EXISTING BEAM GUARDRAIL	0	L.F.
36	6971	PROJECT TEMPORARY TRAFFIC CONTROL	LUMP SUM	LUMP SUM
37	S.P.	NEW BEAM GUARDRAIL SECTION	0	L.F.
38	S.P.	UNDERGROUND UTILITY VERIFICATION POTHOLE	0	EACH

ITEM NO.	STD. ITEM NO.	ITEM DESCRIPTION	TOTAL QUANTITY	UNIT
OTHER ITEMS				
39	7006	STRUCTURE EXCAVATION CLASS B INCL. HAUL	80.50	C.Y.
40	7011	GRAVEL BACKFILL FOR FOUNDATION CLASS A	10	C.Y.
41	7150	GABION CRIBBING	20	C.Y.
42	7490	TRIMMING AND CLEANUP	LUMP SUM	LUMP SUM
43	7562	MAILBOX SUPPORT TYPE 1	0	EACH
44	7725	REIMBURSEMENT FOR THIRD PARTY DAMAGE	EST.	EST.
45	7728	MINOR CHANGE	CALC	CALC
46	7736	SPCC PLAN	LUMP SUM	LUMP SUM
47	6422	SEEDING AND MULCHING	0.25	ACRE

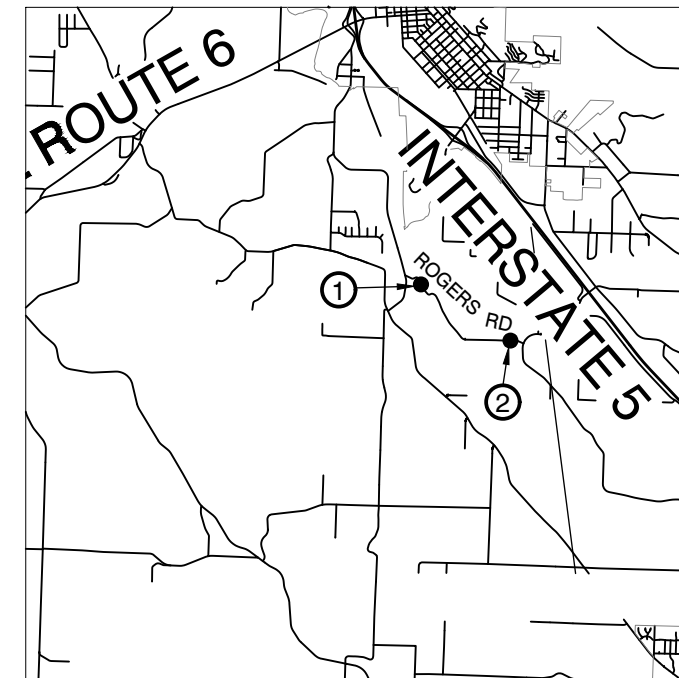

VICINITY MAP
NOT TO SCALE

5/11/2021 10:15 AM

S:\Engineer\Design\2019 COUNTY SAFETY PROGRAM\SUMMARY OF QUANTITIES & LEGEND.dwg

Lewis County
Department of Public Works
2025 NE KRESKY AVE.
CHEHALIS WA 98532
PHONE # (360) 740-1123
FAX # (360) 740-2719

DESIGNED BY : DJC
DRAWN BY : KLP
CHECKED BY :
DATE :

NO.	DATE	REVISION	BY	APP.
1	5/11/2021	ADDED SEEDING AND MULCHING BID ITEM	KLP	GRS
1	5/11/2021	CHANGED QUANTITY OF SELECT BORROW FROM 2 TO 0	KLP	GRS

2019 COUNTY SAFETY PROGRAM PHASE II

FEDERAL-AID NO: HSIP-000S (553)
COUNTY ROAD PROJECT NO: 2191B
ROGERS ROAD
SUMMARY OF QUANTITIES

SHEET
RG1
OF
RG6




Donald J. Carney, P.E.
Senior Engineer/Design
Date: 2/17/21



5/11/2021 10:24 AM

TOWNSHIP 13 NORTH, RANGE 2 WEST W.M.

ALL QUANTITIES FOR CRUSHED SURFACING BASE COURSE INCLUDED IN MAINLINE CLEARING LIMITS AT TOP OF NEW DITCH BACKSLOPE

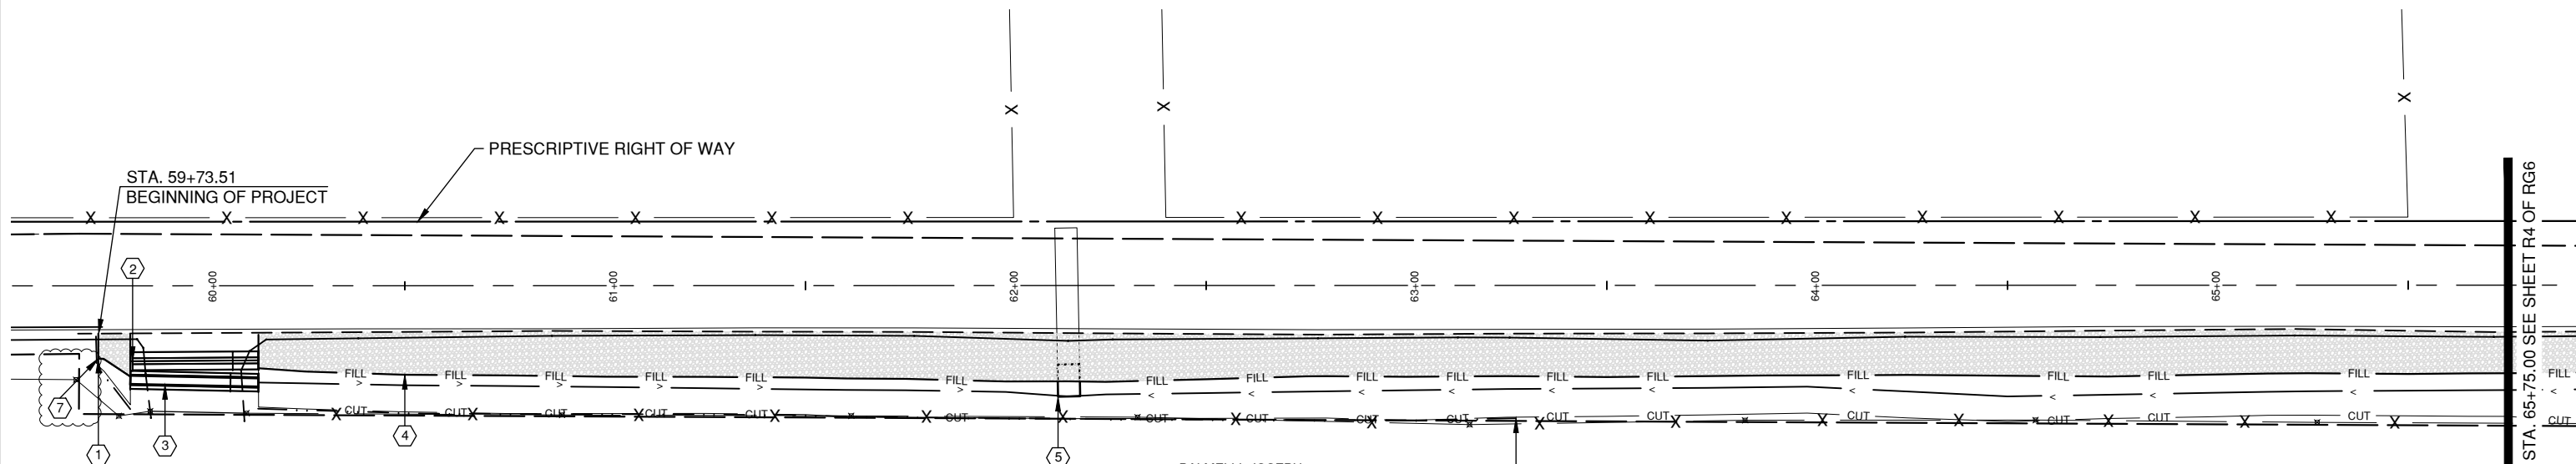

CONSTRUCTION NOTES

- 1 STA. 59+73.51 TO STA. 59+82.08
CONSTRUCT EMBANKMENT
SEE TYPICAL SECTION B-B ON SHEET 3 OF 4
- 2 REMOVE EXISTING CULVERT
10 C.Y. STRUCTURE EXCAVATION CLASS B INCL. HAUL
19 TON CRUSHED SURFACING BASE COURSE
- 3 CONSTRUCT CL. V REINF. CONC. CULV. PIPE 24 IN. DIAM., 32 L.F.
INLET INVERT EL. = 203.28' (STA. 59+81.50) 23.47' RIGHT
OUTLET INVERT EL. = 203.12' (STA. 60+13.49) 24.13' RIGHT
17 C.Y. STRUCTURE EXCAVATION CLASS B INCL. HAUL
32 TON CRUSHED SURFACING BASE COURSE

CONSTRUCTION NOTES

- 4 STA. 60+13.47 TO STA. 69+40.00
CONSTRUCT EMBANKMENT
STEEPEN BACKSLOPE AS NECESSARY TO STAY WITHIN ROW
SEE TYPICAL SECTION B-B ON SHEET 3 OF 4
1 C.Y. ROADWAY EXCAVATION
- 5 EXTEND PLAIN ST. CULV. PIPE ARCH 0.109 IN. TH. 64 IN. SPAN, 8 L.F.
TO CONNECT TO EXISTING PIPE
SEE WSDOT STANDARD PLAN B-60.20
INLET INVERT EL. = 201.13' (STA. 62+15.80), 27.67' RT (MATCH EXISTING PIPE INVERT)
OUTLET INVERT EL. = 201.16' (STA. 62+15.65), 19.67' RT
BEVEL PIPE TO MATCH SLOPE
2 C.Y. STRUCTURE EXCAVATION CLASS B INCL. HAUL
- 6 WATTLE
478 L.F. ENTIRE SITE


CONSTRUCTION NOTES

- 7 SEED AND MULCH ALL EXPOSED AREAS
STA. 59+73.51 TO STA. 59+82.08
STA. 60+13.47 TO STA. 69+40.00
SEEDING AND MULCHING
0.25 ACRES

BALMELLI, JOSEPH
017919000000

SITE 2
ROGERS ROAD MP 1.12
NOT TO SCALE

ROGERS RD FB 723

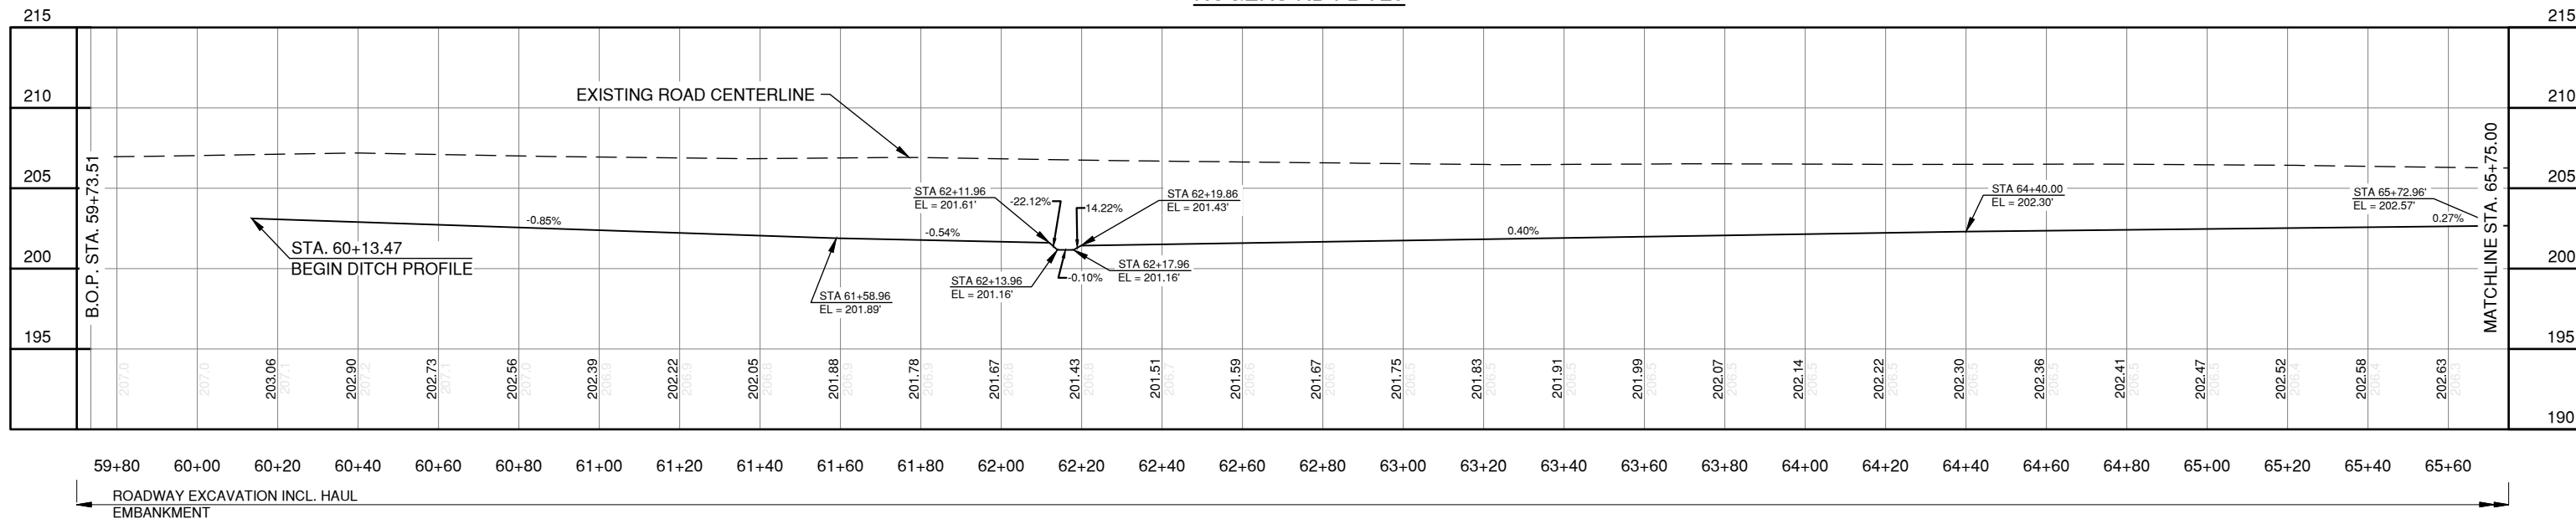

S:\Engineer\Design\2019 COUNTY SAFETY PROGRAM\ROGERS RD\ROGERS RD SITES 1,2 & 3 WITH TOPO.dwg

Lewis County
Department of Public Works
2025 N. E. KRESKY AVE.
CHEHALIS WA 98532
PHONE # (360) 740-1123
FAX # (360) 740-2719

DESIGNED BY : DJC
DRAWN BY : KLP
CHECKED BY :
DATE :

NO.	DATE	REVISION	BY	APP.
1	5/11/2021	ADDED SEEDING AND MULCHING NOTE	KLP	GRS

2019 COUNTY SAFETY PROGRAM
PHASE II

FEDERAL-AID NO: HSIP-000S (553)
COUNTY ROAD PROJECT NO: 2191B
ROGERS ROAD SITE 2

SHEET
RG3
OF
RG6




Donald J. Carney, P.E.
Senior Engineer/Design
Date: 2/17/21



TOWNSHIP 13 NORTH, RANGE 2 WEST W.M.

ALL QUANTITIES FOR CRUSHED SURFACING BASE COURSE INCLUDED IN MAINLINE
CLEARING LIMITS AT TOP OF NEW DITCH BACKSLOPE

5/11/2021 10:24 AM

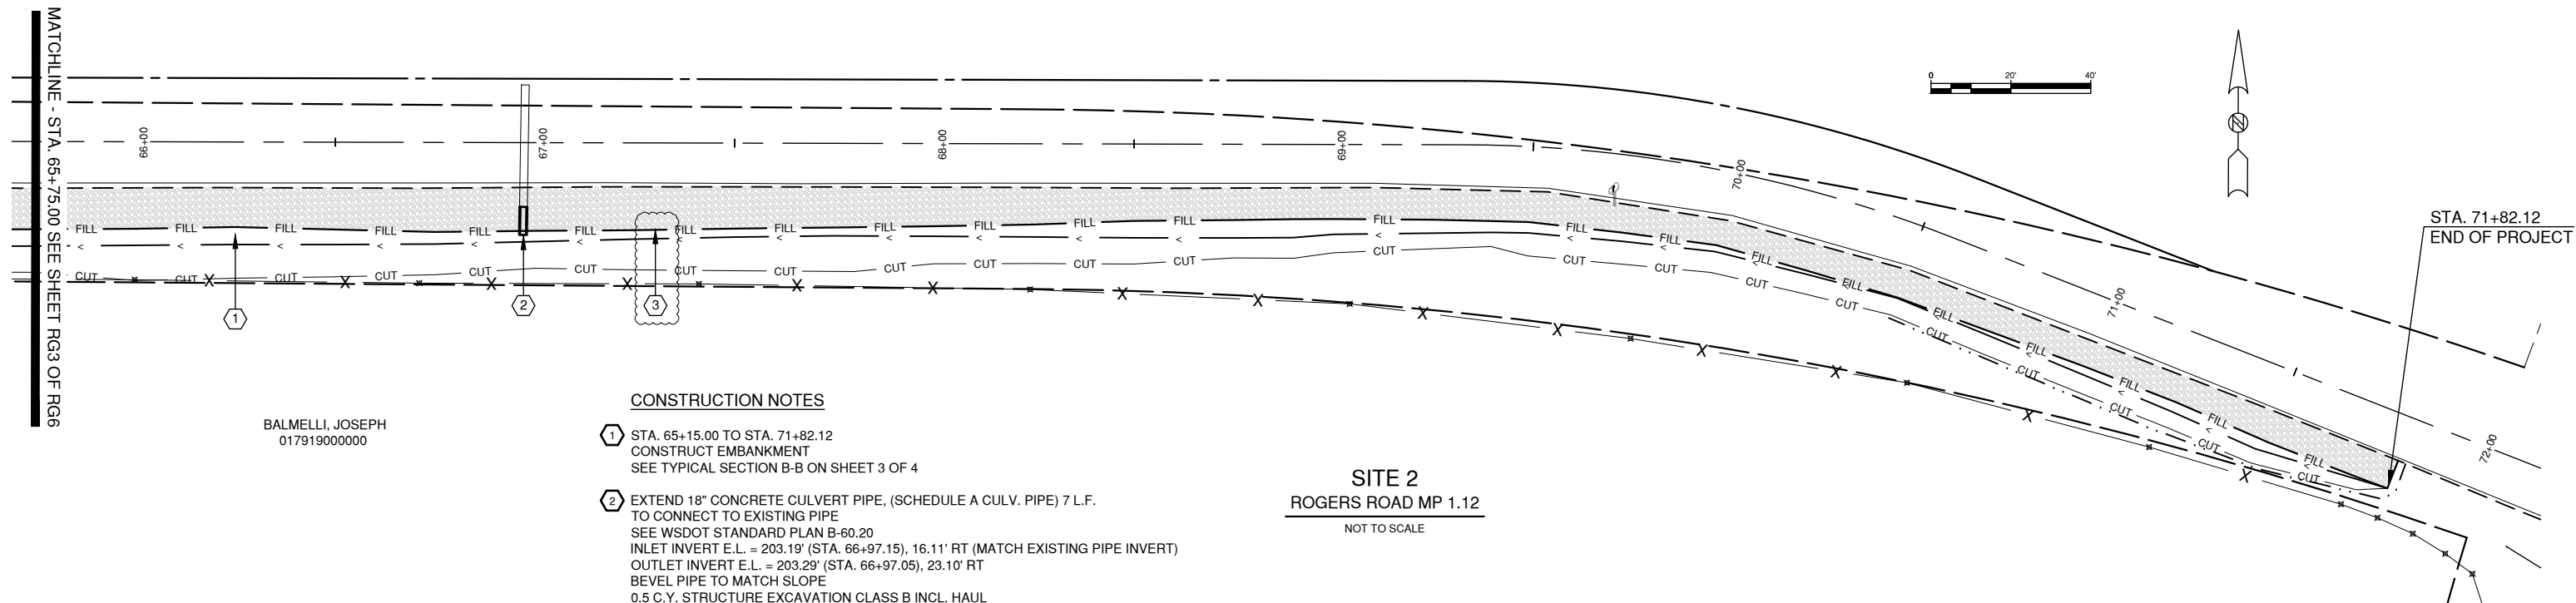


BALMELLI, JOSEPH
017919000000

CONSTRUCTION NOTES

- ① STA. 65+15.00 TO STA. 71+82.12
CONSTRUCT EMBANKMENT
SEE TYPICAL SECTION B-B ON SHEET 3 OF 4
- ② EXTEND 18" CONCRETE CULVERT PIPE, (SCHEDULE A CULV. PIPE) 7 L.F.
TO CONNECT TO EXISTING PIPE
SEE WSDOT STANDARD PLAN B-60.20
INLET INVERT E.L. = 203.19' (STA. 66+97.15), 16.11' RT (MATCH EXISTING PIPE INVERT)
OUTLET INVERT E.L. = 203.29' (STA. 66+97.05), 23.10' RT
BEVEL PIPE TO MATCH SLOPE
0.5 C.Y. STRUCTURE EXCAVATION CLASS B INCL. HAUL
- ③ SEED AND MULCH ALL EXPOSED AREAS
STA. 59+73.51 TO STA. 59+82.08
STA. 60+13.47 TO STA. 69+40.00
SEEDING AND MULCHING
0.25 ACRES

SITE 2
ROGERS ROAD MP 1.12
NOT TO SCALE

ROGERS RD FB 723

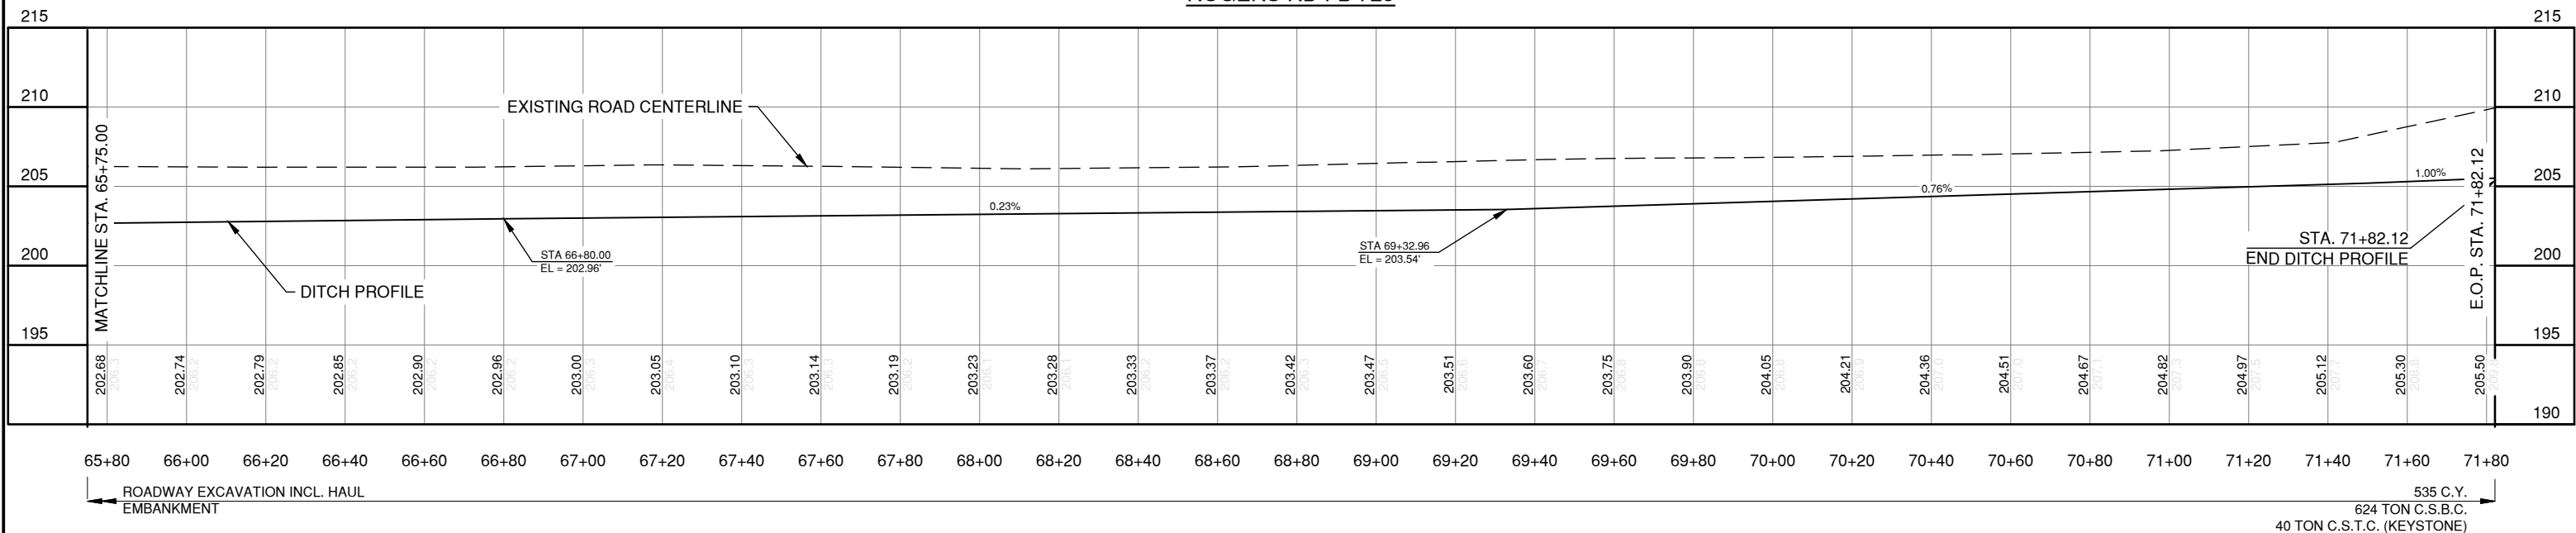

S:\Engineer\Design\2019 COUNTY SAFETY PROGRAM\ROGERS RD\ROGERS RD SITES 1,2 & 3 WITH TOPO.dwg

Lewis County
Department of Public Works
2025 N. E. KRESKY AVE.
CHEHALIS WA 98532
PHONE # (360) 740-1123
FAX # (360) 740-2719

DESIGNED BY : DJC
DRAWN BY : KLP
CHECKED BY :
DATE :

NO.	DATE	REVISION	BY	APP.
1	5/11/2021	ADDED SEEDING AND MULCHING NOTE	KLP	GRS
1	5/11/2021	DELETED SELECT BORROW FROM QUANTITIES	KLP	GRS

2019 COUNTY SAFETY PROGRAM
PHASE II

FEDERAL-AID NO: HSIP-000S (553)
COUNTY ROAD PROJECT NO: 2191B
ROGERS ROAD SITE 2

SHEET
RG4
OF
RG6



Donald J. Carney, P.E.
Senior Engineer/Design
Date: 2/17/21

